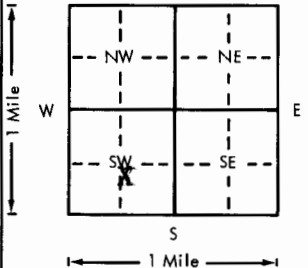


USE TYPEWRITER OR BALL
POINT PEN-PRESS FIRMLY,
PRINT CLEARLY.

WATER WELL RECORD
KSA 82a-1201-1215

Kansas Department of Health and
Environment-Division of Environment
(Water well Contractors)
Topeka, Kansas 66620

1. Location of well:		County Ford	Fraction Center 1/4 SW 1/4	Section number 1	Township number T 28 S R	Range number 26 21W
2. Distance and direction from nearest town or city: 3W, 4S, 1 1/4W, 2S of Dodge City Street address of well location if in city:				3. Owner of well: Charlie Foubks R.R. or street: 107 W. Cimarron City, state, zip code: Cimarron, KS 67835		
4. Locate with "X" in section below:		Sketch map:		6. Bore hole dia. 28 in. Completion date 4-18-77 Well depth 212 ft.		
				7. Cable tool <input type="checkbox"/> Rotary <input type="checkbox"/> Driven <input type="checkbox"/> Dug <input type="checkbox"/> Hollow rod <input type="checkbox"/> Jetted <input type="checkbox"/> Bored <input checked="" type="checkbox"/> Reverse rotary		
				8. Use: Domestic <input type="checkbox"/> Public supply <input type="checkbox"/> Industry <input checked="" type="checkbox"/> Irrigation <input type="checkbox"/> Air conditioning <input type="checkbox"/> Stock <input type="checkbox"/> Lawn <input type="checkbox"/> Oil field water <input type="checkbox"/> Other		
5. Type and color of material				9. Casing: Material steel Height: Above or below Threaded <input type="checkbox"/> Welded <input type="checkbox"/> Surface 12 in. RMP <input type="checkbox"/> PVC <input type="checkbox"/> Weight <input type="checkbox"/> lbs./ft. Dia. 16 in. to 112 ft. depth Wall Thickness: inches or Dia. <input type="checkbox"/> in. to <input type="checkbox"/> ft. depth gauge No. .188		
				10. Screen: Manufacturer's name W. A. Brown Type steel Dia. 16 Slot/gauze 1125 Length 100' Set between 112 ft. and 212 ft. Gravel pack? yes Size range of material <input type="checkbox"/>		
				11. Static water level: 97 ft. below land surface Date 3-6-77 mo./day/yr.		
				12. Pumping level below land surfaces: 107 ft. after 3 hrs. pumping 900 g.p.m. <input type="checkbox"/> ft. after <input type="checkbox"/> hrs. pumping <input type="checkbox"/> g.p.m. Estimated maximum yield 2500 g.p.m.		
				13. Water sample submitted: <input checked="" type="checkbox"/> Yes <input type="checkbox"/> No Date <input type="checkbox"/>		
				14. Well head completion: <input type="checkbox"/> Pitless adapter 12 inches above grade		
				15. Well grouted? <input checked="" type="checkbox"/> X With: <input type="checkbox"/> Neat cement <input type="checkbox"/> Bentonite <input checked="" type="checkbox"/> Concrete Depth: From 0 ft. to 10' ft. MAC		
				16. Nearest source of possible contamination: ft. 3/4 mi. Direction NW Type Farmstead Well disinfected upon completion? <input type="checkbox"/> Yes <input checked="" type="checkbox"/> No		
				17. Pump: <input type="checkbox"/> Not installed Manufacturer's name Simmons Model number 4-SP12 HP 100 Volts <input type="checkbox"/> Length of drop pipe 200 ft. capacity 800 g.p.m. Type: <input type="checkbox"/> Submersible <input checked="" type="checkbox"/> Turbine <input type="checkbox"/> Jet <input type="checkbox"/> Reciprocating <input type="checkbox"/> Centrifugal <input type="checkbox"/> Other		
				(Use a second sheet if needed)		
18. Elevation:		19. Remarks:		20. Water well contractor's certification: This well was drilled under my jurisdiction and this report is true to the best of my knowledge and belief. Woofter Drilling, Inc. 343 Business name Woofter Drilling, Inc. License No. 156 Address 56 Dodge City, KS Signed Michael Woofter Date 4/18/77 Authorized representative		
Topography: <input checked="" type="checkbox"/> Hill <input type="checkbox"/> Slope <input type="checkbox"/> Upland <input type="checkbox"/> Valley						