

1 LOCATION OF WATER WELL:		Fraction		Section Number		Township Number		Range Number	
County:	FORD	NE 1/4	NE 1/4	SE 1/4	10	T 28 S	R 26 E/W		


1 LOCATION OF WATER WELL:		Fraction		Section Number		Township Number		Range Number	
County:	FORD	NE 1/4	NE 1/4	SE 1/4	10	T 28 S	R 26 E/W		

Distance and direction from nearest town or city street address of well if located within city?

7 1/2 South and 7 West of Dodge City, Kansas

2	WATER WELL OWNER:	Mr. LeRoy Reinert	
	RR#, St. Address, Box # :	2000 Burr Parkway	Board of Agriculture, Division of Water Resources
	City, State, ZIP Code :	Dodge City, KS 67801	Application Number: ---

3 LOCATE WELL'S LOCATION WITH AN "X" IN SECTION BOX: 4 DEPTH OF COMPLETED WELL 220 ft. ELEVATION: Slope Not available

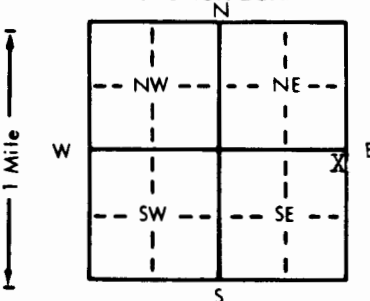

Depth(s) Groundwater Encountered 1. **Not available** ft. 2. ft. 3. ft.
WELL'S STATIC WATER LEVEL **147** ft. below land surface measured on mo/day/yr **August 1, 1985**

Pump test data: Well water was ft. after hours pumping gpm
 Est. Yield .. 30 .. gpm: Well water was ft. after hours pumping gpm
 Bore Hole Diameter .. 9 7/8 in. to .. 220 .. ft. and in. to ft.

WELL WATER TO BE USED AS:		5 Public water supply	8 Air conditioning	11 Injection well
<input checked="" type="checkbox"/> Domestic	3 Feedlot	6 Oil field water supply	9 Dewatering	12 Other (Specify below)
2 Irrigation	4 Industrial	7 Lawn and garden only	10 Observation well

Was a chemical/bacteriological sample submitted to Department? Yes.....No XX.....; If yes, mo/day/yr sample was submitted
Water Well Disinfected? Yes XX No

5	TYPE OF BLANK CASING USED:		5 Wrought iron	8 Concrete tile	CASING JOINTS: Glued . <u>XX</u> . Clamped Welded Threaded
	1 Steel	3 RMP (SR)	6 Asbestos-Cement	9 Other (specify below)	
	XX PVC	4 ABS	7 Fiberglass		

Blank casing diameter . . . 5 . . . in. to . . . 180 . . . ft., Dia . . . in. to . . . ft., Dia . . . in. to . . . ft.
Casing height above land surface . . . 12 . . . in. weight . . . 2.8 . . . lbs./ft. Wall thickness or gauge No. . . . 265.

TYPE OF SCREEN OR PERFORATION MATERIAL:			XX PVC	10 Asbestos-cement
1 Steel	3 Stainless steel	5 Fiberglass	8 RMP (SR)	11 Other (specify)
2 Brass	4 Galvanized steel	6 Concrete tile	9 ABS	12 None used (open hole)

SCREEN OR PERFORATION OPENINGS ARE:		5 Gauzed wrapped	XX 8 Saw cut	11 None (open hole)
1 Continuous slot	3 Mill slot	6 Wire wrapped	9 Drilled holes	
2 Louvered shutter	4 Key punched	7 Torch cut	10 Other (specify)	

SCREEN-PERFORATED INTERVALS: From 180 ft. to 220 ft., From ft. to ft.
From ft. to ft., From ft. to ft.
GRAVEL PACK INTERVALS: From 14 ft. to 220 ft., From ft. to ft.
From ft. to ft., From ft. to ft.

6 GROUT MATERIAL: ☒ Neat cement 2 Cement grout 3 Bentonite 4 Other

Grout Intervals: From 4 ft. to 14 ft. From ft. to ft. From ft. to ft. From ft. to ft.

What is the nearest source of possible contamination:

<input checked="" type="checkbox"/> Septic tank	4 Lateral lines	7 Pit privy	10 Livestock pens	14 Abandoned water well
2 Sewer lines	5 Cess pool	8 Sewage lagoon	11 Fuel storage	15 Oil well/Gas well
3 Watertight sewer lines	6 Seepage pit	9 Feedyard	12 Fertilizer storage	16 Other (specify below)
			13 Insecticide storage

Direction from well?	North	How many feet?	1300
----------------------	-------	----------------	------

[illegible]

7] CONTRACTOR'S OR LANDOWNER'S CERTIFICATION: This water well was (1) constructed, (2) reconstructed, or (3) plugged under my jurisdiction and was completed on (mo/day/year) August 5, 1985 and this record is true to the best of my knowledge and belief. Kansas

Water Well Contractor's License No. 252 This Water Well Record was completed on (mo/day/yr) August 9, 1985
under the business name of FRIESEN WINDMILL & SUPPLY INC. by (signature)

INSTRUCTIONS: Use typewriter or ball point pen, PLEASE PRESS FIRMLY and PRINT clearly. Please fill in blanks, underline or circle the correct answers. Send top three copies to Kansas Department of Health and Environment, Division of Environment, Environmental Geology Section, Topeka, KS 66620. Send one to WATER WELL OWNER and retain one for your records.

1700000000-22