

USE TYPEWRITER OR BALL POINT PEN-PRESS FIRMLY, PRINT CLEARLY.

T R EW sec 1/4 1/4 1/4 No.

WATER WELL RECORD
KSA 82a-1201-1215

Kansas State Dept. Of Health
(Water Well Contractors)
Forbes-Bldg. 740
Topeka, Kansas 66620


1 Location of well:	County	Township name	Fraction	Section number	Town number	Range number
	FORD	CONCORD	NE 1/4 NE 1/4	18	285	26 W

Distance and direction from nearest town or city: **2 mi South + 2 mi East of ENSIGN KS**

3 Owner of well: **STEPHEN R. SAYRE**

Street address of well location if in city: _____

Address: **MONTENZUMA, KS 67867**

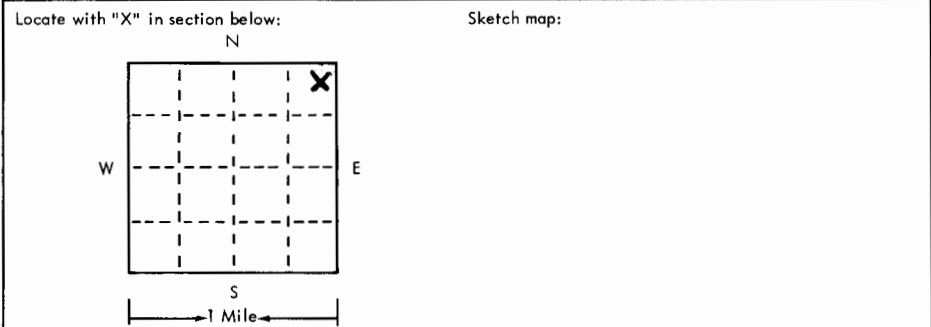

4 Well depth: **200** ft. Date of completion: **17/3/75**
Well diameter **8** in.

5 Cable tool Rotary Driven Dug
 Hollow rod Jetted Bored Reverse rotary

6 Use: Domestic Public supply Industry
 Irrigation Air conditioning Commercial
 Test well _____

7 Casing: Material **PLASTIC** Height: above/below _____
Threaded Welded Surface **20** in.
Diam. **GLUE** Weight _____ lbs./ft. _____
5 in. to **200** ft. depth Drive shoe? Yes No
_____ in. to _____ ft. depth

2

Type and color of material	From	To
SOIL	0	2
CLAY	2	100
CLAY + ROCK	100	140
DRY GRAVEL	140	170
WET GRAVEL + CLAY	170	190
ROCK + CLAY	190	200
(use a second sheet if needed)		

8 Screen:
Manufacturer **LESS + LOWELL**
Type **RMP** Dia. **5**
~~5/8~~ gauge Length **30 FT**
Set between **170** ft. and **200** ft.
Fittings:
Gravel pack Yes No Size range of material **1/8**

9 Static water level:
170 ft. below land surface Date **15/3/75**

10 Pumping level below land surfaces: **NA**
____ ft. after _____ hrs. pumping _____ g.p.m.
____ ft. after _____ hrs. pumping _____ g.p.m.
Estimated maximum yield _____ g.p.m.

11 Water sample submitted:
 Yes No Date _____

12 Well head completion: **20**
 Pitless adapter Inches above grade

13 Well grouted? Yes No
 Neat cement Bentonite _____
Depth: From **3** ft. to **13** ft.

14 Nearest source of possible contamination:
1 mile Direction **East** Type **SEWER**
Well disinfected upon completion? Yes No

15 Pump: Not installed
Manufacturer's name **REDA**
Model number **40189157** HP **1 1/2** Volts **230**
Length of drop pipe **189** ft. capacity **1000** g.m.p.
Type:
 Submersible Turbine
 Jet Reciprocating
 Centrifugal Other

16 Remarks: elevation

Topography:
 Hill
 Slope
 Upland
 Valley

17 Water well contractor's certification:
This well was drilled under my jurisdiction and this report is true to the best of my knowledge and belief.

CRAGG Well Drilling III
Business name _____ License No. _____
Address **Box 1, Dodge City KS**
Signed **Gary Dewey** Date **17/3/75**
Authorized representative