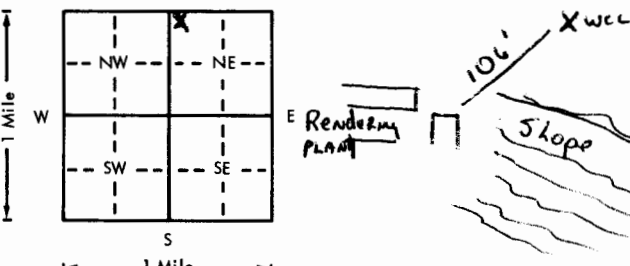


USE TYPEWRITER OR BALL
POINT PEN—PRESS FIRMLY,
PRINT CLEARLY.

WATER WELL RECORD
KSA 82a-1201-1215

Kansas Department of Health and
Environment-Division of Environment
(Water well Contractors)
Topeka, Kansas 66620

1. Location of well:		County FORD	Fraction NW 1/4 NW 1/4 NE 1/4	Section number 26	Township number T 28	Range number S R 26	E/W E/W
2. Distance and direction from nearest town or city: 13 miles SW Dodge				3. Owner of well: Arthur Foote			
Street address of well location if in city:				R.R. or street: 711 D			
				City, state, zip code: Dodge City ks 67801			
4. Locate with "X" in section below:		Sketch map:		6. Bore hole dia. 9 in. Completion date 2/1/16			
				Well depth 200 ft.			
				7. Cable tool <input checked="" type="checkbox"/> Rotary <input type="checkbox"/> Driven <input type="checkbox"/> Dug <input type="checkbox"/> Hollow rod <input type="checkbox"/> Jetted <input type="checkbox"/> Bored <input type="checkbox"/> Reverse rotary			
				8. Use: <input type="checkbox"/> Domestic <input type="checkbox"/> Public supply <input checked="" type="checkbox"/> Industry <input type="checkbox"/> Irrigation <input type="checkbox"/> Air conditioning <input type="checkbox"/> Stock <input type="checkbox"/> Lawn <input type="checkbox"/> Oil field water <input type="checkbox"/> Other			
				9. Casing: Material PVC Height: Above or below <input type="checkbox"/> Threading: <input type="checkbox"/> Welded <input type="checkbox"/> Surface 20 in. RMP <input type="checkbox"/> PVC <input checked="" type="checkbox"/> Weight 250 lbs./ft. Dia. 5 in. to 200 ft. depth Wall Thickness: inches or Dia. 5 in. to 200 ft. depth Gauge No. 250			
5. Type and color of material		From		To		10. Screen: Manufacturer's name Jess Howell	
Topsoil		0		3		Type PVC Dia. 5	
Clay		3		37		Set between 170 ft. and 200 ft. 11/16 Length 3	
Rock		37		71		Gravel pack? <input checked="" type="checkbox"/> Size range of material 1/2	
SAND		71		84		11. Static water level: 167 ft. below land surface Date 4/2/16	
Clay		84		167		12. Pumping level below land surfaces: N/A	
GRAVEL		167		200		Estimated maximum yield _____ g.p.m.	
						13. Water sample submitted: _____ mo./day/yr.	
						14. Well head completion: <input checked="" type="checkbox"/> Pitless adapter 20 inches above grade	
						15. Well grouted? <input checked="" type="checkbox"/> With: <input checked="" type="checkbox"/> Neat cement <input type="checkbox"/> Bentonite <input type="checkbox"/> Concrete Depth: From 0 ft. to 25 ft.	
						16. Nearest source of possible contamination: Rendering plant ft. 106 Direction SW Type Plant	
						Well disinfected upon completion? <input checked="" type="checkbox"/> Yes <input type="checkbox"/> No	
						17. Pump: <input checked="" type="checkbox"/> Not installed	
						Manufacturer's name _____ HP _____ Volts _____	
						Length of drop pipe _____ ft. capacity _____ g.p.m.	
						Type: <input type="checkbox"/> Submersible <input type="checkbox"/> Turbine <input type="checkbox"/> Jet <input type="checkbox"/> Reciprocating <input type="checkbox"/> Centrifugal <input type="checkbox"/> Other	
18. Elevation:		19. Remarks:		20. Water well contractor's certification:			
Topography: <input checked="" type="checkbox"/> Hill <input checked="" type="checkbox"/> Slope <input type="checkbox"/> Upland <input type="checkbox"/> Valley		Send More Forms		This well was drilled under my jurisdiction and this report is true to the best of my knowledge and belief.			
				CRAIG DRILLING License No. 111			
				Business name Rt 1 Dek Address Ray, Mo Date 2/1/16			
				Signed _____ Authorized representative			