

WATER WELL RECORD Form WWC-5 KSA 82a-1212

1 LOCATION OF WATER WELL:	Fraction	Section Number	Township Number	Range Number
County: <i>Gray</i>	<i>NW 1/4 NE 1/4 NW 1/4</i>	<i>7</i>	<i>T 28 S</i>	<i>R 27 EW</i>


Distance and direction from nearest town or city street address of well if located within city?

*Heggerd, KS 6 miles west of Ensign, KS on Highway 56*2 WATER WELL OWNER: *Dodge City Cooperative Exchange*RR#, St. Address, Box #: *Dodge 710 W Trail*City, State, ZIP Code: *Dodge City, KS 67801*

Board of Agriculture, Division of Water Resources

Application Number:

3 LOCATE WELL'S LOCATION WITH AN "X" IN SECTION BOX:

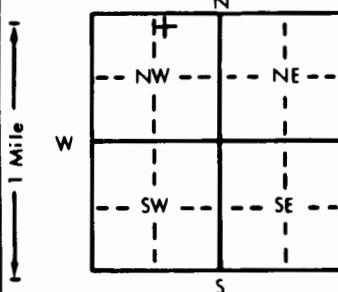

4 DEPTH OF COMPLETED WELL ft. ELEVATION:

Depth(s) Groundwater Encountered 1. ft. 2. ft. 3. ft.

WELL'S STATIC WATER LEVEL ft. below land surface measured on mo/day/yr

Pump test data: Well water was ft. after hours pumping gpm

Est. Yield gpm: Well water was ft. after hours pumping gpm

Bore Hole Diameter 8.0 in. to 11.5 ft. and in. to ft.

WELL WATER TO BE USED AS: 5 Public water supply 8 Air conditioning 11 Injection well

1 Domestic 3 Feedlot 6 Oil field water supply 9 Dewatering ⑩ Other (Specify below)

2 Irrigation 4 Industrial 7 Lawn and garden only ⑪ Monitoring well *Exploratory Boring SB-b*

Was a chemical/bacteriological sample submitted to Department? Yes No. If yes, mo/day/yr sample was submitted

Water Well Disinfected? Yes No

5 TYPE OF BLANK CASING USED:

1 Steel 3 RMP (SR)
2 PVC 4 ABS

5 Wrought iron

8 Concrete tile

CASING JOINTS: Glued Clamped

6 Asbestos-Cement
7 Fiberglass

9 Other (specify below)

Welded

Threaded

Blank casing diameter in. to ft. Dia in. to ft. Dia in. to ft.

Casing height above land surface in. weight lbs./ft. Wall thickness or gauge No.

TYPE OF SCREEN OR PERFORATION MATERIAL:

1 Steel 3 Stainless steel

5 Fiberglass

7 PVC

10 Asbestos-cement

2 Brass 4 Galvanized steel

6 Concrete tile

8 RMP (SR)

11 Other (specify)

9 ABS

12 None used (open hole)

SCREEN OR PERFORATION OPENINGS ARE:

1 Continuous slot 3 Mill slot

5 Gauzed wrapped

8 Saw cut

11 None (open hole)

2 Louvered shutter 4 Key punched

6 Wire wrapped

9 Drilled holes

7 Torch cut

10 Other (specify)

SCREEN-PERFORATED INTERVALS: From ft. to ft. From ft. to ft. From ft. to ft.

From ft. to ft. From ft. to ft. From ft. to ft.

GRAVEL PACK INTERVALS: From ft. to ft. From ft. to ft. From ft. to ft.

From ft. to ft. From ft. to ft. From ft. to ft.

6 GROUT MATERIAL: 1 Neat cement ② Cement grout 3 Bentonite 4 Other

Grout Intervals: From 0 ft. to 11.5 ft. From ft. to ft. From ft. to ft. From ft. to ft.

What is the nearest source of possible contamination:

1 Septic tank 4 Lateral lines

7 Pit privy

10 Livestock pens

14 Abandoned water well

2 Sewer lines 5 Cess pool

8 Sewage lagoon

11 Fuel storage

15 Oil well/Gas well

3 Watertight sewer lines 6 Seepage pit

9 Feedyard

12 Fertilizer storage

⑥ Other (specify below)

Direction from well? 100

13 Insecticide storage

Former UST Basin

How many feet?

South

FROM TO LITHOLOGIC LOG FROM TO PLUGGING INTERVALS

0 .4 Asphalt pavement 0 115 cement grout

.4 7.0 Clay

7 15 clayey silt

15 25.5 Sand

25.5 30.5 Silt

30.5 86.5 Sand

86.5 115 Silty Clay

7 CONTRACTOR'S OR LANDOWNER'S CERTIFICATION: This water well was (1) constructed, (2) reconstructed, or (3) plugged under my jurisdiction and was completed on (mo/day/year) 9/20/95 and this record is true to the best of my knowledge and belief. Kansas

Water Well Contractor's License No. 540 This Water Well Record was completed on (mo/day/yr) 10/12/95

under the business name of Prairie Land Environmental Remediation Inc. by (signature) *JCD/NL*