

1 LOCATION OF WATER WELL:	Fraction	Section Number	Township Number	Range Number
County: Gray	NW $\frac{1}{4}$ NE $\frac{1}{4}$ NW $\frac{1}{4}$	7	T 28 S	R 27 EW

Distance and direction from nearest town or city street address of well if located within city?

Haggard, KS 6mi West of Ensign, KS on Highway 56


2 WATER WELL OWNER: Dodge City Cooperative Exchange

RR#, St. Address, Box #: 710 W. Trail

City, State, ZIP Code: Dodge City, KS 67801

Board of Agriculture, Division of Water Resources
Application Number:

3 LOCATE WELL'S LOCATION WITH AN "X" IN SECTION BOX:

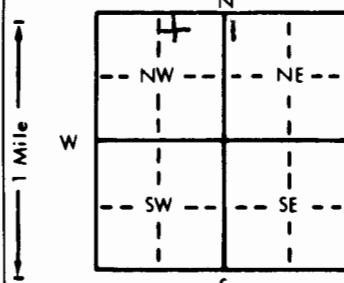

4 DEPTH OF COMPLETED WELL: 210 ft. ELEVATION:

Depth(s) Groundwater Encountered 1 190 ft. 2. ft. 3. ft.

WELL'S STATIC WATER LEVEL ft. below land surface measured on mo/day/yr

Pump test data: Well water was ft. after hours pumping gpm

Est. Yield gpm: Well water was ft. after hours pumping gpm

Bore Hole Diameter 12 in. to 220 ft. and in. to ft.

WELL WATER TO BE USED AS: 5 Public water supply 8 Air conditioning 11 Injection well

1 Domestic 3 Feedlot 6 Oil field water supply 9 Dewatering 12 Other (Specify below)

2 Irrigation 4 Industrial 7 Lawn and garden only 10 Monitoring well MW-6

Was a chemical/bacteriological sample submitted to Department? Yes No If yes, mo/day/yr sample was submitted

Water Well Disinfected? Yes No ✓

5 TYPE OF BLANK CASING USED:

1 Steel 3 RMP (SR)
2 PVC 4 ABS

5 Wrought iron

6 Asbestos-Cement

7 Fiberglass

8 Concrete tile

9 Other (specify below)

CASING JOINTS: Glued Clamped

Welded

Threaded

Blank casing diameter 4 in. to 180 ft., Dia in. to ft., Dia in. to ft.

Casing height above land surface 0 in., weight lbs./ft. Wall thickness or gauge No. Sch 40

TYPE OF SCREEN OR PERFORATION MATERIAL:

1 Steel 3 Stainless steel
2 Brass 4 Galvanized steel

5 Fiberglass

6 Concrete tile

7 Gauzed wrapped

8 Wire wrapped

9 RMP (SR)

10 ABS

7 PVC

11 Asbestos-cement

12 Other (specify)

13 None used (open hole)

SCREEN OR PERFORATION OPENINGS ARE:

1 Continuous slot 3 Mill slot
2 Louvered shutter 4 Key punched

5 Torch cut

6 Saw cut

7 Drilled holes

8 Other (specify)

SCREEN-PERFORATED INTERVALS: From 180 ft. to 210 ft., From ft. to ft.

From ft. to ft., From ft. to ft.

GRAVEL PACK INTERVALS: From 175 ft. to 220 ft., From ft. to ft.

From ft. to ft., From ft. to ft.

6 GROUT MATERIAL: 1 Neat cement 2 Cement grout 3 Bentonite 4 Other

Grout Intervals: From 0 ft. to 172 ft., From 172 ft. to 175 ft., From ft. to ft.

What is the nearest source of possible contamination:

1 Septic tank 4 Lateral lines
2 Sewer lines 5 Cess pool
3 Watertight sewer lines 6 Seepage pit7 Pit privy
8 Sewage lagoon
9 Feedyard

10 Livestock pens

11 Fuel storage

12 Fertilizer storage

13 Insecticide storage

14 Abandoned water well

15 Oil well/Gas well


16 Other (specify below)

Direction from well? Northwest

How many feet? 50

FROM	TO	LITHOLOGIC LOG	FROM	TO	PLUGGING INTERVALS
0	.2	clayey Sand			
.2	13.4	silty clay			
13.4	38.6	clayey silt			
38.6	57.5	silty sand			
57.5	86.5	silt and sand			
86.5	103	clayey silt			
103	119	clayey silty sand			
119	123.5	clayey silt			
123.5	134.5	silty sand			
134.5	158	sandy clayey silt			
158	185	sandy silty clay			
185	188	silty sand			
188		Sand			

7 CONTRACTOR'S OR LANDOWNER'S CERTIFICATION: This water well was (1) constructed, (2) reconstructed, or (3) plugged under my jurisdiction and was completed on (mo/day/year) 11/21/95 and this record is true to the best of my knowledge and belief. Kansas

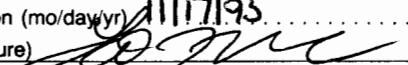Water Well Contractor's License No. 540 This Water Well Record was completed on (mo/day/yr) 11/17/95 under the business name of Prairie Land Environmental Remediation Inc by (signature) 

INSTRUCTIONS: Use typewriter or ball point pen. PLEASE PRESS FIRMLY and PRINT clearly. Please fill in blanks, underline or circle the correct answers. Send top three copies to Kansas Department of Health and Environment, Bureau of Water, Topeka, Kansas 66620-0001. Telephone: 913-296-5545. Send one to WATER WELL OWNER and retain one for your records.