

## 1 LOCATION OF WATER WELL:

Fraction

NW  $\frac{1}{4}$  NE  $\frac{1}{4}$  NW  $\frac{1}{4}$ 

Section Number

7

Township Number

T

28

S

Range Number

R 27

E/W

Distance and direction from nearest town or city street address of well if located within city?

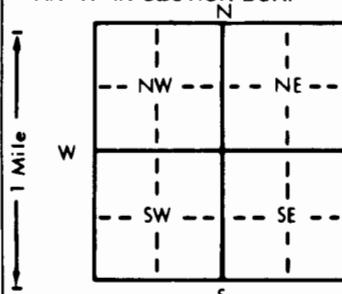
Haggard, KS 6mi West of Ensign, KS on Highway 56

## 2 WATER WELL OWNER:

Dodge City Cooperative Exchange

RR#, St. Address, Box # 710 W. 7th

City, State, ZIP Code Dodge City, KS 67801

Board of Agriculture, Division of Water Resources  
Application Number:3 LOCATE WELL'S LOCATION WITH  
AN "X" IN SECTION BOX:

## 4 DEPTH OF COMPLETED WELL 210 ft. ELEVATION:

Depth(s) Groundwater Encountered 1 ft. 2 ft. 3 ft. ft.

WELL'S STATIC WATER LEVEL 192.02 ft. below land surface measured on mo/day/yr 11/16/95

Pump test data: Well water was ft. after hours pumping gpm

Est. Yield gpm: Well water was ft. after hours pumping gpm

Bore Hole Diameter 12 in. to 220 ft. and in. to ft.

WELL WATER TO BE USED AS: 5 Public water supply 8 Air conditioning 11 Injection well

1 Domestic 3 Feedlot 6 Oil field water supply 9 Dewatering 12 Other (Specify below)

2 Irrigation 4 Industrial 7 Lawn and garden only 10 Monitoring well MW-5

Was a chemical/bacteriological sample submitted to Department? Yes No ✓ If yes, mo/day/yr sample was submitted

Water Well Disinfected? Yes No ✓

## 5 TYPE OF BLANK CASING USED:

1 Steel 3 RMP (SR)  
2 PVC 4 ABS

5 Wrought iron

8 Concrete tile

CASING JOINTS: Glued Clamped

6 Asbestos-Cement

9 Other (specify below)

Welded

7 Fiberglass

Threaded ✓

Blank casing diameter 4 in. to 210 ft., Dia in. to ft., Dia in. to ft.

Casing height above land surface 0 in., weight lbs./ft. Wall thickness or gauge No. sch 40

## TYPE OF SCREEN OR PERFORATION MATERIAL:

1 Steel 3 Stainless steel  
2 Brass 4 Galvanized steel

5 Fiberglass

8 RMP (SR)

10 Asbestos-cement

6 Concrete tile

9 ABS

11 Other (specify)

5 Gauzed wrapped

12 None used (open hole)

11

None (open hole)

## SCREEN OR PERFORATION OPENINGS ARE:

1 Continuous slot 3 Mill slot  
2 Louvered shutter 4 Key punched

6 Wire wrapped

8 Saw cut

9 Drilled holes

7 Torch cut

10 Other (specify)

SCREEN-PERFORATED INTERVALS: From 180 ft. to 210 ft., From ft. to ft.

From ft. to ft., From ft. to ft.

GRAVEL PACK INTERVALS: From 170 ft. to 220 ft., From ft. to ft.

From ft. to ft., From ft. to ft.

## 6 GROUT MATERIAL: 1 Neat cement 2 Cement grout 3 Bentonite 4 Other

Grout Intervals: From 0 ft. to 167 ft., From 167 ft. to 170 ft., From ft. to ft.

10 Livestock pens 14 Abandoned water well

11 Fuel storage 15 Oil well/Gas well

12 Fertilizer storage 16 Other (specify below)

13 Insecticide storage Former UST B251n

How many feet? 200

Direction from well? West

FROM	TO	LITHOLOGIC LOG	FROM	TO	PLUGGING INTERVALS
0	.4	sand & Gravel			
.4	6.2	Clay			
6.2	12.5	silty Clay			
12.5	46.4	clay and silt			
46.4	57.5	silty Sand			
57.5	64	sandy silty clayey silt			
64	78	silty Sand			
78	110.5	clay and silt			
110.5	119	silty Sand			
119	153.5	clayey silt			
153	184	silty Clay			
184	188	silty Sand			
188		Sand			

## 7 CONTRACTOR'S OR LANDOWNER'S CERTIFICATION: This water well was (1) constructed, (2) reconstructed, or (3) plugged under my jurisdiction and was completed on (mo/day/year) 10/26/95 and this record is true to the best of my knowledge and belief. Kansas

Water Well Contractor's License No. 540 This Water Well Record was completed on (mo/day/yr) 11/17/95 under the business name of Prairie Land Environmental Remediation Inc. by (signature)