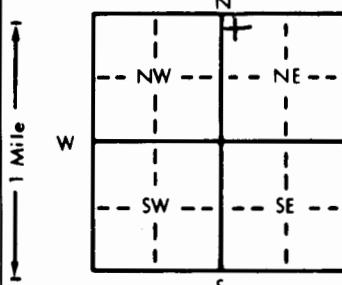


WATER WELL RECORD Form WWC-5 KSA 82a-1212

1 LOCATION OF WATER WELL:	Fraction	Section Number	Township Number	Range Number
County: Gray	NW 1/4 NE 1/4 NW 1/4	7	T 28 S	R 27 E

Distance and direction from nearest town or city street address of well if located within city?

Haggard, KS 6mi West of Ensign, KS on Highway 562 WATER WELL OWNER: **Dodge City Cooperative Exchange**RR#, St. Address, Box #: **710 W Trail**City, State, ZIP Code: **Dodge City, KS 6780**Board of Agriculture, Division of Water Resources
Application Number:3 LOCATE WELL'S LOCATION WITH
AN "X" IN SECTION BOX:4 DEPTH OF COMPLETED WELL **210** ft. ELEVATION:Depth(s) Groundwater Encountered **1. 188.5** ft. 2. ft. 3. ft.WELL'S STATIC WATER LEVEL **193.75** ft. below land surface measured on mo/day/yr **11/16/95**

Pump test data: Well water was ft. after hours pumping gpm

Est. Yield gpm: Well water was ft. after hours pumping gpm

Bore Hole Diameter **12** in. to **215** ft., and in. to ft.

WELL WATER TO BE USED AS: 5 Public water supply 8 Air conditioning 11 Injection well

1 Domestic 3 Feedlot 6 Oil field water supply 9 Dewatering 12 Other (Specify below)

2 Irrigation 4 Industrial 7 Lawn and garden only **10** Monitoring well **MW-3**Was a chemical/bacteriological sample submitted to Department? Yes No If yes, mo/day/yr sample was submittedWater Well Disinfected? Yes No

5 TYPE OF BLANK CASING USED:

1 Steel **3** RMP (SR)
2 PVC **4** ABSBlank casing diameter **64.9** in. to **180** ft., Dia in. to ft., Dia in. to ft.Casing height above land surface **0** in., weight lbs./ft. Wall thickness or gauge No. **sch 40**

TYPE OF SCREEN OR PERFORATION MATERIAL:

1 Steel **3** Stainless steel
2 Brass **4** Galvanized steel

5 Wrought iron

6 Asbestos-Cement

7 Fiberglass

8 Concrete tile

9 Other (specify below)

CASING JOINTS: Glued Clamped

Welded

Threaded

SCREEN OR PERFORATION OPENINGS ARE:

1 Continuous slot **3** Mill slot
2 Louvered shutter **4** Key punched**7** PVC

10 Asbestos-cement

SCREEN-PERFORATED INTERVALS: From **180** ft. to **210** ft., From ft. to ft.

From ft. to ft., From ft. to ft.

GRAVEL PACK INTERVALS: From **175** ft. to **215** ft., From ft. to ft.

From ft. to ft., From ft. to ft.

6 GROUT MATERIAL: **1** Neat cement **2** Cement grout **3** Bentonite **4** OtherGrout Intervals: From **0** ft. to **172** ft., From **172** ft. to **175** ft., From ft. to ft.

What is the nearest source of possible contamination:

1 Septic tank **4** Lateral lines
2 Sewer lines **5** Cess pool
3 Watertight sewer lines **6** Seepage pit

10 Livestock pens

14 Abandoned water well

11 Fuel storage

15 Oil well/Gas well

12 Fertilizer storage

16 Other (specify below)

13 Insecticide storage

Former VST BasinHow many feet? **50**Direction from well? **East**

FROM	TO	LITHOLOGIC LOG	FROM	TO	PLUGGING INTERVALS
0	.5	Back fill sand and cobbles			
.5	2.0	silty clay			
2.0	4.5	silty sand			
4.5	17.2	clayey sand			
17.2	22.5	clayey silty sand			
22.5	32.7	sandy silty clay			
32.7	83.5	clayey silty sand			
83.5	100.5	clayey silt			
100.5	116.5	silty sand			
116.5	124	clayey silt			
124	133.5	silty sand			
133.5	165	clayey silt			
165	187.5	clayey silty sand			
187.5		sand			

7 CONTRACTOR'S OR LANDOWNER'S CERTIFICATION: This water well was **1** constructed, **2** reconstructed, or **3** plugged under my jurisdiction and was completed on (mo/day/year) **10/14/95** and this record is true to the best of my knowledge and belief. KansasWater Well Contractor's License No. **540** This Water Well Record was completed on (mo/day/yr) **11/16/95** under the business name of **Prairie Land Environmental Remediation Inc.** by (signature) **JG**INSTRUCTIONS: Use typewriter or ball point pen. **PLEASE PRESS FIRMLY** and **PRINT** clearly. Please fill in blanks, underline or circle the correct answers. Send top three copies to Kansas Department of Health and Environment, Bureau of Water, Topeka, Kansas 66620-0001. Telephone: 913-296-5545. Send one to WATER WELL OWNER and retain one for your records.