

1 LOCATION OF WATER WELL:

Fraction

County: *Gray*NW $\frac{1}{4}$ NE $\frac{1}{4}$ NW $\frac{1}{4}$

Section Number

7

Township Number

T

28

S

Range Number

R 27

EW

Distance and direction from nearest town or city street address of well if located within city?


*Haggard, KS 6mi West of Ensign KS on Highway 56*2 WATER WELL OWNER: *Dodge City Cooperative Exchange*RR#, St. Address, Box # : *710 W. Tr 21*

Board of Agriculture, Division of Water Resources

City, State, ZIP Code : *Dodge City, KS 67801*

Application Number:

3 LOCATE WELL'S LOCATION WITH AN "X" IN SECTION BOX:

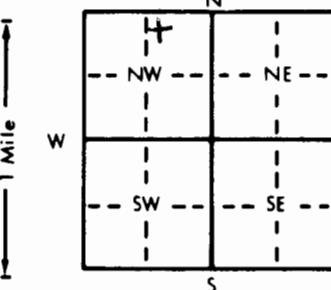

4 DEPTH OF COMPLETED WELL:

ft. ELEVATION:

Depth(s) Groundwater Encountered 1. *188.5* ft. 2. ft. 3. ft.

WELL'S STATIC WATER LEVEL ft. below land surface measured on mo/day/yr

Pump test data: Well water was ft. after hours pumping gpm

Est. Yield gpm: Well water was ft. after hours pumping gpm

Bore Hole Diameter *12* in. to *188.5* ft. and in. to ft.

WELL WATER TO BE USED AS: 5 Public water supply 8 Air conditioning 11 Injection well

1 Domestic 3 Feedlot 6 Oil field water supply 9 Dewatering Other (Specify below)

2 Irrigation 4 Industrial 7 Lawn and garden only 10 Monitoring well *(Exploratory boring SB-2)*Was a chemical/bacteriological sample submitted to Department? Yes No If yes, mo/day/yr sample was submittedWater Well Disinfected? Yes No

5 TYPE OF BLANK CASING USED:

1 Steel 3 RMP (SR)
2 PVC 4 ABS

5 Wrought iron

8 Concrete tile

CASING JOINTS: Glued Clamped

6 Asbestos-Cement

9 Other (specify below)

Welded

7 Fiberglass

Threaded

Blank casing diameter in. to ft. Dia in. to ft. Dia in. to ft.

Casing height above land surface in., weight lbs./ft. Wall thickness or gauge No.

TYPE OF SCREEN OR PERFORATION MATERIAL:

1 Steel 3 Stainless steel
2 Brass 4 Galvanized steel

5 Fiberglass

7 PVC

10 Asbestos-cement

6 Concrete tile

8 RMP (SR)

11 Other (specify)

SCREEN OR PERFORATION OPENINGS ARE:

1 Continuous slot 3 Mill slot
2 Louvered shutter 4 Key punched

5 Gauzed wrapped

8 Saw cut

11 None (open hole)

6 Wire wrapped

9 Drilled holes

7 Torch cut

10 Other (specify)

SCREEN-PERFORATED INTERVALS: From ft. to ft. From ft. to ft.

From ft. to ft. From ft. to ft.

GRAVEL PACK INTERVALS: From ft. to ft. From ft. to ft.

From ft. to ft. From ft. to ft.

6 GROUT MATERIAL: 1 Neat cement 2 Cement grout 3 Bentonite 4 Other

Grout Intervals: From ft. to ft. From ft. to ft. From ft. to ft. From ft. to ft.

What is the nearest source of possible contamination: 10 Livestock pens 14 Abandoned water well

1 Septic tank 4 Lateral lines 7 Pit privy 11 Fuel storage 15 Oil well/Gas well
2 Sewer lines 5 Cess pool 8 Sewage lagoon 12 Fertilizer storage 16 Other (specify below)
3 Watertight sewer lines 6 Seepage pit 9 Feedyard 13 Insecticide storage

Former UST basin

How many feet? *North*

FROM	TO	LITHOLOGIC LOG	FROM	TO	PLUGGING INTERVALS
0	7.8	Sand	0	3'	Surface Silt and clay
7.8	16.5	clayey silt	3	10'	Cement grout
16.5	22.5	silty clay	10	188.5	Vol clay grout
22.5	45.5	clayey silt			
45.5	57.4	silty sand			
57.4	64.4	clayey silt			
64.4	84.5	silt and sand			
84.5	100	clayey silt			
100	135	silt and sand			
125	135	silty clay			
135	187	sandy silty clay			
187	48				
		Sand			

7 CONTRACTOR'S OR LANDOWNER'S CERTIFICATION: This water well was (1) constructed, (2) reconstructed, or (3) plugged under my jurisdiction and was completed on (mo/day/year) *11/16/95* and this record is true to the best of my knowledge and belief. KansasWater Well Contractor's License No. *540* This Water Well Record was completed on (mo/day/yr) *11/17/95*under the business name of *Prairie Land Environmental Remediation Inc.* by (signature) *JO JZ*