drl

WATER WELL RECORD Form NE SE NW KSA 82a-1212 ID No. _____

1 LOCATION OF WATER WELL:	Fraction	Section Number	Township Number	Range Number
County: Gray	~~NW~~ ¼ ~~SE~~ ¼ ~~NE~~ ¼	32	T 28 S	R 27 E (W)

Distance and direction from nearest town or city street address of well if located within city?
5½S + 3¼W from Ensign

2 WATER WELL OWNER: Ila Edwards
RR#, St. Address, Box # :
City, State, ZIP Code : Fowler, KS 67844

Board of Agriculture, Division of Water Resources Application Number:

3 LOCATE WELL'S LOCATION WITH AN "X" IN SECTION BOX:

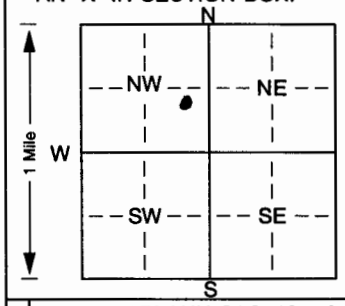

4 DEPTH OF COMPLETED WELL 240 ft. ELEVATION:
Depth(s) Groundwater Encountered 1. 126 ft. 2. ft. 3. ft.
WELL'S STATIC WATER LEVEL ~~142~~ 126 ft. below land surface measured on mo/day/yr 5-6-02
Pump test data: Well water was ~~142~~ 126 ft. after 1 hours pumping 30 gpm
Est. Yield 50 gpm: Well water was ft. after hours pumping gpm
Bore Hole Diameter 8 3/4 in. to 240 ft., and in. to ft.
WELL WATER TO BE USED AS: (1) Domestic 2 Irrigation 3 Feedlot 4 Industrial 5 Public water supply 6 Oil field water supply 7 Domestic (lawn & garden) 8 Air conditioning 9 Dewatering 10 Monitoring well 11 Injection well 12 Other (Specify below)
Was a chemical/bacteriological sample submitted to Department? Yes No ✓; If yes, mo/day/yrs sample was submitted
Water Well Disinfected? Yes ✓ No

5 TYPE OF BLANK CASING USED: 1 Steel (3) PVC 3 RMP (SR) 4 ABS 5 Wrought iron 6 Asbestos-Cement 7 Fiberglass 8 Concrete tile 9 Other (specify below)
CASING JOINTS: Glued ✓ Clamped Welded Threaded
Blank casing diameter 5 in. to 200 ft., Dia in. to ft., Dia in. to ft.
Casing height above land surface 24 in., weight lbs./ft. Wall thickness or gauge No. 200# 250#

TYPE OF SCREEN OR PERFORATION MATERIAL: (1) PVC 1 Steel 2 Brass 3 Stainless steel 4 Galvanized steel 5 Fiberglass 6 Concrete tile 8 RMP (SR) 9 ABS 10 Asbestos-cement 11 Other (specify) 12 None used (open hole)
SCREEN OR PERFORATION OPENINGS ARE: 1 Continuous slot 2 Louvered shutter (3) Mill slot 4 Key punched 5 Gauzed wrapped 6 Wire wrapped 7 Torch cut 8 Saw cut 9 Drilled holes 10 Other (specify) 11 None (open hole)
SCREEN-PERFORATED INTERVALS: From 200 ft. to 240 ft., From ft. to ft.
From ft. to ft., From ft. to ft.
GRAVEL PACK INTERVALS: From 20 ft. to 240 ft., From ft. to ft.
From ft. to ft., From ft. to ft.

6 GROUT MATERIAL: 1 Neat cement 2 Cement grout (3) Bentonite 4 Other
Grout Intervals: From top ft. to 20 ft., From ft. to ft., From ft. to ft.
What is the nearest source of possible contamination: (1) Septic tank 2 Sewer lines 3 Watertight sewer lines 4 Lateral lines 5 Cess pool 6 Seepage pit 7 Pit privy 8 Sewage lagoon 9 Feedyard 10 Livestock pens 11 Fuel storage 12 Fertilizer storage 13 Insecticide storage 14 Abandoned water well 15 Oil well/Gas well 16 Other (specify below)
Direction from well? W How many feet? 2600

FROM	TO	LITHOLOGIC LOG	FROM	TO	PLUGGING INTERVALS
0	5	topsoil		220'-240'	5" Eagle PVC 120 SDR-17
5	38	brown clay			250 PSI @ 73°F ASTM D 2241
38	50	Sand			NSF-PW Well Casing IC-0
50	55	dark brown clay			ASTM F480-99 NSF-WC
55	75	brown clay			BL101 4 Hastings NE 25:310D196
75	175	sand + gravel			
175	194	blue clay		220-top	Northern Pipe Products 5" SDR 21
194	240	sand + gravel w/ streaks of clay			200 psi @ 73°F PVC 1120 ASTM
					D 2241 NFS-PW B1373
					F#20CR 43D

7 CONTRACTOR'S OR LANDOWNER'S CERTIFICATION: This water well was (1) constructed, (2) reconstructed, or (3) plugged under my jurisdiction and was completed on (mo/day/year) 5-7-02 and this record is true to the best of my knowledge and belief. Kansas Water Well Contractor's Licence No. 101 This Water Well Record was completed on (mo/day/yr) 5-15-02 under the business name of Bartel Well Drilling, Inc. by (signature) Reuben J Bartel

INSTRUCTIONS: Use typewriter or ball point pen. *PLEASE PRESS FIRMLY* and *PRINT* clearly. Please fill in blanks, underline or circle the correct answers. Send top three copies to Kansas Department of Health and Environment, Bureau of Water, Topeka, Kansas 66620-0001. Telephone 785-296-5524. Send one to WATER WELL OWNER and retain one for your records. Fee of $5.00 for each constructed well.