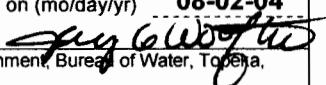


1 LOCATION OF WATER WELL: County: Gray		Fraction NW ¼ NE ¼ NW ¼	Section Number 7	Township Number T 28 S	Range Number R 27 E	
Distance and direction from nearest town or city street address of well if located within city?						
2 WATER WELL OWNER: Dodge City Coop % Terry Cramer						
RR#, St. Address, Box # : Hwy 56			Board of Agriculture, Division of Water Resources			
City, State, ZIP Code : Dodge City, KS 67801			Application Number: SV-1			
3 LOCATE WELL'S LOCATON WITH AN "X" IN SECTION BOX:		4 DEPTH OF COMPLETED WELL 75 ft. ELEVATION:				
		Depth(s) Groundwater Encountered 1 ft. 2 ft. 3 ft. WELL'S STATIC WATER LEVEL ft. below land surface measured on mo/day/yr Pump test data: Well water was ft. after hours pumping gpm Est. Yield gpm: Well water was ft. after hours pumping gpm Bore Hole Diameter 8 in. to 75 ft. and in. to ft. WELL WATER TO BE USED AS: 5 Public water supply 8 Air conditioning 11 Injection well 1 Domestic 3 Feed lot 6 Oil field water supply 9 Dewatering 12 Other (Specify below) 2 Irrigation 4 Industrial 7 Lawn and garden (domestic) 10 Monitoring well SV				
Was a chemical/bacteriological sample submitted to Department? Yes No X If yes, mo/day/yr sample was submitted Water Well Disinfected? Yes No X						
5 TYPE OF BLANK CASING USED:						
1 Steel	3 RMP (SR)	5 Wrought Iron	8 Concrete tile	CASING JOINTS: Glued Clamped		
<input checked="" type="checkbox"/> 2 PVC	4 ABS	6 Asbestos-Cement	9 Other (specify below)	Welded		
Blank casing diameter 4 in. to 10 ft. Dia	in. to 2.071 lbs./ft. Wall thickness or gauge No. .237	7 Fiberglass	10 Asbestos-cement	Threaded X		
Casing height above land surface 0 in., weight						
TYPE OF SCREEN OR PERFORATION MATERIAL:						
1 Steel	3 Stainless steel	5 Fiberglass	8 RMP (SR)	10 Asbestos-cement		
2 Brass	4 Galvanized steel	6 Concrete tile	9 ABS	11 Other (specify)		
SCREEN OR PERFORATION OPENINGS ARE:						
1 Continuous slot	3 Mill slot	5 Gauzed wrapped	7 PVC	12 None used (open hole)		
2 Louvered shutter	4 Key punched	6 Wire wrapped	8 Saw cut	11 None (open hole)		
7 Torch cut		9 Drilled holes				
10 Other (specify)		10 Other (specify)				
SCREEN-PERFORATED INTERVALS: From 10 ft. to 75 ft. From ft. to ft.						
GRAVEL PACK INTERVALS: From 8 ft. to 75 ft. From ft. to ft.						
From ft. to ft. From ft. to ft.						
6 GROUT MATERIAL: 1 Neat cement 2 Cement grout 3 Bentonite 4 Other						
Grout Intervals From 0 ft. to 8 ft. From	ft. to	ft. From	ft. to	ft. From	ft. to	
What is the nearest source of possible contamination:						
1 Septic tank	4 Lateral lines	7 Pit privy	10 Livestock pens	14 Abandoned water well		
2 Sewer lines	5 Cess pool	8 Sewage lagoon	11 Fuel storage	15 Oil well/ Gas well		
3 Watertight sewer lines	6 Seepage pit	9 Feedyard	12 Fertilizer storage	<input checked="" type="checkbox"/> 16 Other (specify below)		
Contaminated Site						
Direction from well?						
How many feet?						
FROM	TO	CODE	LITHOLOGIC LOG	FROM	TO	PLUGGING INTERVALS
0	2		Mixed Sand , Gravel & Cobbles			
2	8		Light, Brown, Slightly Stained			
			Slightly Silty Clay			
8	32		Red Brown clayey Silt			
32	40		Reddish Brown Silt			
40	52		Light Gray to Pink Silty Clay			
			To Clayey Silt			
52	75		Very Fine Grained Silty Sand			
			To ver fine grained Sandy Silt			
7 CONTRACTOR'S OR LANDOWNER'S CERTIFICATION: This water well was (1) constructed, (2) reconstructed, or (3) plugged under my jurisdiction and was completed on (mo/day/yr) 7-1-04 and this record is true to the best of my knowledge and belief. Kansas Water Well Contractor's License No. 554 This Water Well Record was completed on (mo/day/yr) 08-02-04 under the business name of Woofter Pump & Well, Inc. by (signature) 						
INSTRUCTIONS: Please fill in blanks and circle the correct answers. Send three copies to Kansas Department of Health and Environment, Bureau of Water, Topeka, Kansas 66620-0001. Telephone: 913-296-5545. Send one to WATER WELL OWNER and retain one for your records.						

OFFICE USE ONLY

SEC