

1 LOCATION OF WATER WELL:	Fraction	Section Number	Township Number	Range Number
County: Gray	NW ¼ NE ¼ NW ¼	7	T 28 S	R 27 EW

Distance and direction from nearest town or city street address of well if located within city?

2 WATER WELL OWNER: **Dodge City Coop % Terry Cramer**RR#, St. Address, Box #: **HWY 56**


Board of Agriculture, Division of Water Resources

City, State, ZIP Code: **Haggard, Ks**

SV-2

Application Number:

3 LOCATE WELL'S LOCATION WITH AN "X" IN SECTION BOX:

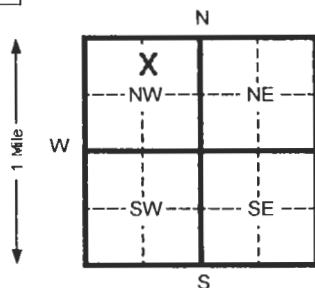

4 DEPTH OF COMPLETED WELL

200 ft. ELEVATION:

Depth(s) Groundwater Encountered 1 _____ ft. 2 _____ ft. 3 _____ ft.

WELL'S STATIC WATER LEVEL _____ ft. below land surface measured on mo/day/yr

Pump test data: Well water was _____ ft. after _____ hours pumping _____ gpm

Est. Yield _____ gpm: Well water was _____ ft. after _____ hours pumping _____ gpm

Bore Hole Diameter **8** in. to **200** ft. and _____ in. to _____ ft.

WELL WATER TO BE USED AS: 5 Public water supply 8 Air conditioning 11 Injection well

1 Domestic 3 Feed lot 6 Oil field water supply 9 Dewatering 12 Other (Specify below)

2 Irrigation 4 Industrial 7 Lawn and garden (domestic) ☒ Monitoring wellWas a chemical/bacteriological sample submitted to Department? Yes _____ No ☒ If yes, mo/day/yr sample was submittedWater Well Disinfected? Yes _____ No ☒

5 TYPE OF BLANK CASING USED:

5 Wrought Iron

8 Concrete tile

CASING JOINTS: Glued _____ Clamped _____

1 Steel

3 RMP (SR)

6 Asbestos-Cement

9 Other (specify below)

Welded _____

X ☒ 2 PVC

4 ABS

7 Fiberglass

Threaded ☒Blank casing diameter **4** in. to **50** ft. Dia _____ in. to _____ ft. Dia _____ in. to _____ ft.Casing height above land surface **0** in., weight **2.071** lbs./ft. Wall thickness or gauge No. **.237**

TYPE OF SCREEN OR PERFORATION MATERIAL:

1 Steel

3 Stainless steel

5 Fiberglass

☒ 7 PVC

10 Asbestos-cement

2 Brass

4 Galvanized steel

6 Concrete tile

8 RMP (SR)

11 Other (specify)

9 ABS

12 None used (open hole)

SCREEN OR PERFORATION OPENINGS ARE:

1 Continuous slot

3 Mill slot

5 Gauzed wrapped

☒ 8 Saw cut

11 None (open hole)

2 Louvered shutter

4 Key punched

6 Wire wrapped

9 Drilled holes

7 Torch cut

10 Other (specify)

SCREEN-PERFORATED INTERVALS:

From **50** ft. to **200** ft. From _____ ft. to _____ ft.

From _____ ft. to _____ ft. From _____ ft. to _____ ft.

GRAVEL PACK INTERVALS:

From **48** ft. to **200** ft. From _____ ft. to _____ ft.

From _____ ft. to _____ ft. From _____ ft. to _____ ft.

6 GROUT MATERIAL:

1 Neat cement

2 Cement grout

☒ 3 Bentonite

4 Other _____

Grout Intervals From **1** ft. to **43** ft. From _____ ft. to _____ ft. From _____ ft. to _____ ft.

What is the nearest source of possible contamination:

1 Septic tank

4 Lateral lines

7 Pit privy

10 Livestock pens

14 Abandoned water well

2 Sewer lines

5 Cess pool

8 Sewage lagoon

11 Fuel storage

15 Oil well/ Gas well

3 Watertight sewer lines

6 Seepage pit

9 Feedyard

12 Fertilizer storage

16 Other (specify below)

13 Insecticide storage

CONTAMINATED SITE

Direction from well?

How many feet?

FROM	TO	CODE	LITHOLOGIC LOG	FROM	TO	PLUGGING INTERVALS
0	3		Road & drive, sd & gravel			Med grained sand grains
3	20		Silty clay	174	184	Very fine to med grained sd, clayey, some
20	36		Fine to very fine gr silty sd, loose			Coarse grained, small gravel
36	40		Clayey silt to silty clay, slightly	184	198	Dense blocky clay, slightly sandy, some
			Sandy, very fine grained			Caliche
40	60		Silty clay to clayey silt, abund cal	198	200	Clay, more fractured
60	78		Fine gr sandy silt to silty sd, abund caliche			
78	88		very fine grained silty sand			
88	94		Sandy clay w/abund cal strks & nod			
94	120		Silty clay to clayey silt, abund cal, Stringer very fine gr sand			
120	174		Sandy clay to clayey very fine gr Sand, abund cal, w/some fine to			

7 CONTRACTOR'S OR LANDOWNER'S CERTIFICATION: This water well was (1) constructed, (2) reconstructed, or (3) plugged under my jurisdiction and was

completed on (mo/day/yr)

9-904

and this record is true to the best of my knowledge and belief. Kansas

Water Well Contractor's License No.

554

This Water Well Record was completed on (mo/day/yr)

10-6-04

under the business name of

Woofert Pump & Well Inc.

by (signature)

INSTRUCTIONS: Please fill in blanks and circle the correct answers. Send three copies to Kansas Department of Health and Environment, Bureau of Water, Topeka, Kansas 66620-0001. Telephone: 913-296-5545. Send one to WATER WELL OWNER and retain one for your records.