

WATER WELL RECORD Form WWC-5 KSA 82a-1212

1 LOCATION OF WATER WELL:

Fraction

County: Gray

NW ¼ NE ¼ NW ¼

Section Number

Township Number

Range Number

7

T 28 S

R 27 E/W

Distance and direction from nearest town or city street address of well if located within city?

Highway 56, Haggard

2 WATER WELL OWNER:

Terry Cramer

RR#, St. Address, Box #

710 W. Trail


Board of Agriculture, Division of Water Resources

City, State, ZIP Code

Dodge City, KS 67801

Application Number:

3 LOCATE WELL'S LOCATION WITH AN "X" IN SECTION BOX:

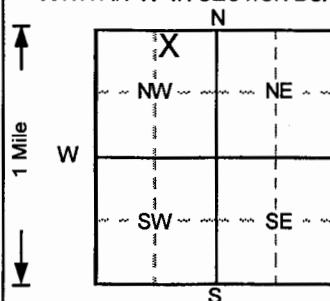

4 DEPTH OF COMPLETED WELL 75 ft. ELEVATION: 0

Depth(s) Groundwater Encountered 1 ft. 2 ft. 3 ft.

WELL'S STATIC WATER LEVEL ft. below land surface measured on mo/day/yr

Pump test data: Well water was NA ft. after hours pumping gpm

Est. Yield .. NA... gpm: Well water was ft. after hours pumping gpm

Bore Hole Diameter .. 11 ... in. to 75 ft., and in. to ft.

WELL WATER TO BE USED AS: 5 Public water supply 8 Air conditioning 11 Injection well

1 Domestic 3 Feedlot 6 Oil field water supply 9 Dewatering 12 Other (Specify below)

2 Irrigation 4 Industrial 7 Lawn and garden only 10 Monitoring well ... Soil vapor extractio.

Was a chemical/bacteriological sample submitted to Department? Yes.....No ✓ ..; If yes, mo/day/yr sample was submitted

Water Well Disinfected? Yes No ✓

5 TYPE OF BLANK CASING USED:

1 Steel 3 RMP (SR)
2 PVC 4 ABS

5 Wrought iron

8 Concrete tile

CASING JOINTS: Glued Clamped

6 Asbestos-Cement

9 Other (specify below)

Welded

7 Fiberglass

Threaded. ✓

Blank casing diameter 4 in. to 35 ft., Dia in. to ft., Dia in. to ft.

Casing height above land surface 0 in., weight lbs./ft. Wall thickness or gauge No. Sch. 40

TYPE OF SCREEN OR PERFORATION MATERIAL

1 Steel 3 Stainless steel
2 Brass 4 Galvanized steel

5 Fiberglass

8 RMP (SR)

10 Asbestos-cement

6 Concrete tile

9 ABS

11 Other (specify)

SCREEN OR PERFORATION OPENINGS ARE:

1 Continuous slot 3 Mill slot
2 Louvered shutter 4 Key punched

5 Gauzed wrapped

8 Saw cut

11 None (open hole)

6 Wire wrapped

9 Drilled holes

7 Torch cut

10 Other (specify)

SCREEN-PERFORATED INTERVALS: From 35 ft. to 75 ft., From ft. to ft.

From ft. to ft., From ft. to ft.

GRAVEL PACK INTERVALS: From 33 ft. to 75 ft., From ft. to ft.

From ft. to ft., From ft. to ft.

6 GROUT MATERIAL: 1 Neat cement 2 Cement grout 3 Bentonite 4 Other Concrete

Grout Intervals: From 0 ft. to 3 ft., From 3 ft. to 33 ft., From ft. to ft.

What is the nearest source of possible contamination:

1 Septic tank 4 Lateral lines
2 Sewer lines 5 Cess pool
3 Watertight sewer lines 6 Seepage pit7 Pit privy
8 Sewage lagoon
9 Feedyard

10 Livestock pens

14 Abandoned water well

11 Fuel storage

15 Oil well/Gas well

12 Fertilizer storage

16 Other (specify below)

13 Insecticide storage

How many feet? 0

Direction from well?

FROM	TO	LITHOLOGIC LOG	FROM	TO	PLUGGING INTERVALS
0	0.5	Gravel and sand (fill),	67	72	Sand (vf), v. silty, sl. clayey, moist, Lt. Brown
0.5	6	Clay, v. silty, moist, plastic, no odor, Dark Bro	72	75	Sand (vf-m), v. clayey, tight, sl. gas odor, Whit
6	12	Clay, v. silty, moist, plastic, no odor, Lt. Brow			
12	18	Clay, v. silty, abundant white calc., Lt. Brown			
18	22	Clay, v. silty, sl. sandy, moist, no odor, Yellowi			
22	26	Silt, clayey, sl. sandy, decr. white calc. nod., Y			
26	36	Silt, incr. sand (vf), clayey, Yellowish Brown			
36	42	Sand (vf), v. silty, moist, no odor, Lt. Brown			
42	43.5	Clay, v. sandy, silty, tight, no odor, Tan mottle			
43.5	48	Sand (vf), silty, sl. clayey, no odor, Lt. Brown			
48	53.25	Sand (vf-f) v. silty, white calc. mat., Lt. Brown			
53.25	54	Clay, v. sandy (vf), tight, sl. varnish odor, Lt.			
54	61	Sand (vf-f), v. silty, moist, varnish odor, Lt. Br			SVE3 , Tag # 00379584 , Flushmount
61	63	Sand (vf-c), v. silty, tight, varnish odor, White			Project Name: GF - Dodge City Coop - Haggard
63	67	Sand (vf-f), v. silty, sl. varnish odor, Brown w/			GeoCore # 1321 , KDHE # U1 035 00468

7 CONTRACTOR'S OR LANDOWNER'S CERTIFICATION: This water well was (1) constructed, (2) reconstructed, or (3) plugged under my jurisdiction

and was completed on (mo/day/year) 10/26/2006 and this record is true to the best of my knowledge and belief.

Kansas Water Well Contractor's License No. 527 This Water Well Record was completed on (mo/day/year) 11/9/2006

under the business name of

GeoCore, Inc.

by (signature) *Dale Holt*