

USE TYPEWRITER OR BALL
POINT PEN-PRESS FIRMLY,
PRINT CLEARLY.

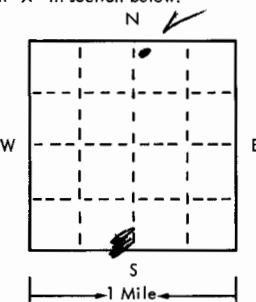
--	--	--	--	--	--	--	--

T R EW sec 1/4 1/4 1/4 No.

WATER WELL RECORD
KSA 82a-1201-1215

Kansas State Dept. of Health
(Water Well Contractors)
Forbes-Bldg. 740
Topeka, Kansas 66620

WELL No. 2

1 Location of well:	County GRAY	Township name EAST HESS	Fraction NE $\frac{1}{4}$	Section number 1	Town number 28	Range number 27
Distance and direction from nearest town or city: SOUTH SIDE OF FORO-ENSIGN ROAD 1 MILE EAST Street address of well location if in city: ENSIGN KAN.			3 Owner of well: JOE KONECNY Address: 1700-8th. DODGECITY KAN			
Locate with "X" in section below: 						
Sketch map: 						
4 Well depth:	208 ft. Date of completion _____					
Well diameter:	28 in.					
5	<input type="checkbox"/> Cable tool <input type="checkbox"/> Rotary <input type="checkbox"/> Driven <input type="checkbox"/> Dug <input type="checkbox"/> Hollow rod <input type="checkbox"/> Jetted <input type="checkbox"/> Bored <input checked="" type="checkbox"/> Reverse rotary					
6 Use:	<input type="checkbox"/> Domestic <input type="checkbox"/> Public supply <input type="checkbox"/> Industry <input checked="" type="checkbox"/> Irrigation <input type="checkbox"/> Air conditioning <input type="checkbox"/> Commercial <input type="checkbox"/> Test well					
7 Casing:	Material STEEL Height: above/below Threaded <input type="checkbox"/> Welded <input checked="" type="checkbox"/> Surface _____ in. Diam. _____ Weight _____ lbs./ft. 16 in. to 208 ft. depth Drive shoe? <input type="checkbox"/> Yes <input type="checkbox"/> No _____ in. to _____ ft. depth					
8 Screen:	Manufacturer WA BROWN Type BRIDGE Dia. 16 Slot/gauze 1 Length _____ Set between 768 ft. and 208 ft. Fittings: Gravel pack <input checked="" type="checkbox"/> Yes <input type="checkbox"/> No Size range of material _____					
9 Static water level:	150 ft. below land surface Date _____					
10 Pumping level below land surfaces:	190 ft. after 1 hrs. pumping 1400 g.p.m. _____ ft. after _____ hrs. pumping _____ g.p.m. Estimated maximum yield 1400 g.p.m.					
11 Water sample submitted:	<input type="checkbox"/> Yes <input checked="" type="checkbox"/> No Date _____					
12 Well head completion:	<input type="checkbox"/> Pitless adapter <input checked="" type="checkbox"/> Inches above grade					
13 Well grouted?	<input checked="" type="checkbox"/> Yes <input type="checkbox"/> No <input type="checkbox"/> Neat cement <input type="checkbox"/> Bentonite <input type="checkbox"/> CEMENT Depth: From _____ ft. to _____ ft.					
14 Nearest source of possible contamination:	ENSIGN ft. 1500 Direction NE Type DISPOSAL PITS					
15 Pump:	<input checked="" type="checkbox"/> Not installed Manufacturer's name HYDRO Model number _____ HP _____ Volts _____ Length of drop pipe 905 ft. capacity 1400 g.m.p. Type: <input type="checkbox"/> Submersible <input checked="" type="checkbox"/> Turbine <input type="checkbox"/> Jet <input type="checkbox"/> Reciprocating <input type="checkbox"/> Centrifugal <input type="checkbox"/> Other					
16 Remarks: elevation						
Topography:	<input type="checkbox"/> Hill <input type="checkbox"/> Slope <input checked="" type="checkbox"/> Upland <input type="checkbox"/> Valley					
(use a second sheet if needed)						
17 Water well contractor's certification:	This well was drilled under my jurisdiction and this report is true to the best of my knowledge and belief. JOE Johnson Drilling 183 Business name JOE JOHNSON DRILLING CO. License No. _____ Address DODGECITY KAN. Signed JOE JOHNSON Date 10-3-18 Authorized representative _____					