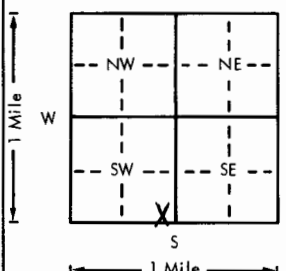
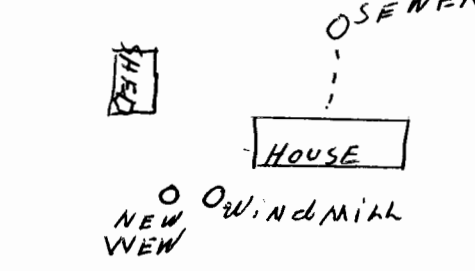


USE TYPEWRITER OR BALL
POINT PEN-PRESS FIRMLY,
PRINT CLEARLY.

WATER WELL RECORD
KSA 82a-1201-1215

Kansas Department of Health and
Environment-Division of Environment
(Water well Contractors)
Topeka, Kansas 66620

1. Location of well:		County Gray	Fraction SE 1/4 SE 1/4 SW 1/4	Section number 6	Township number T 28 S R 27	Range number 27
2. Distance and direction from nearest town or city:		3. Owner of well: Richard Figger				
Street address of well location if in city: in town		R.R. or street:				
No. street # LOCATION		City, state, zip code: Haggard, Kansas 67835				
4. Locate with "X" in section below:		Sketch map:				
						
5. Type and color of material		From	To	6. Bore hole dia. 8 in. Completion date 3-6-77		
Top soil & clay		0	15	Well depth 240 ft.		
Clay		15	135	7. Cable tool <input checked="" type="checkbox"/> Rotary <input type="checkbox"/> Driven <input type="checkbox"/> Dug		
Clay & fine sand layers		135	180	<input type="checkbox"/> Hollow rod <input type="checkbox"/> Jetted <input type="checkbox"/> Bored <input type="checkbox"/> Reverse rotary		
Clay & fine sand layers & medium sand		180	195	8. Use: <input checked="" type="checkbox"/> Domestic <input type="checkbox"/> Public supply <input type="checkbox"/> Industry		
Clay layers & medium sand		195	210	<input type="checkbox"/> Irrigation <input type="checkbox"/> Air conditioning <input type="checkbox"/> Stock		
Fine to medium sand		210	225	<input type="checkbox"/> Lawn <input type="checkbox"/> Oil field water <input type="checkbox"/> Other		
Medium sand & clay & blue shale		225	240	9. Casing: Material RMP Height: Above 12 in.		
				Threaded <input type="checkbox"/> Welded <input type="checkbox"/> Surface 12 in.		
				RMP xx PVC <input type="checkbox"/> Weight 250 lbs./ft.		
				Dia. 5 in. to 240 ft. depth Wall Thickness: inches or		
				Dia. 5 in. to 240 ft. depth gage No. 250		
				10. Screen: Manufacturer's name Sunflower		
				Type RMP Dia. 5 in.		
				Slot 1/8 in. Length 20 ft.		
				Set between 195 ft. and 235 ft.		
				Gravel pack? yes Size range of material 1/4 in.		
				11. Static water level: 175 ft. below land surface Date 3-6-77		
				12. Pumping level below land surfaces:		
				ft. after 5 hrs. pumping 1 g.p.m.		
				ft. after 5 hrs. pumping 1 g.p.m.		
				Estimated maximum yield 1 g.p.m.		
				13. Water sample submitted: Yes <input checked="" type="checkbox"/> No <input type="checkbox"/> Date 3-6-77		
				14. Well head completion: X Pitless adapter 12 inches above grade		
				15. Well grouted? yes		
				With: X Neat cement <input type="checkbox"/> Bentonite <input type="checkbox"/> Concrete		
				Depth: From 5 ft. to 20 ft.		
				16. Nearest source of possible contamination: 105 ft. Direction NE Type Sewer		
				Well disinfected upon completion? X Yes <input type="checkbox"/> No		
				17. Pump: <input type="checkbox"/> Not installed		
				Manufacturer's name Aermotor		
				Model number SD12-100 HP 1 Volts 230		
				Length of drop pipe 210 ft. capacity 12 g.p.m.		
				Type: <input checked="" type="checkbox"/> Submersible <input type="checkbox"/> Turbine		
				<input type="checkbox"/> Jet <input type="checkbox"/> Reciprocating		
				<input type="checkbox"/> Centrifugal <input type="checkbox"/> Other		
18. Elevation:		19. Remarks:				
Topography:						
<input type="checkbox"/> Hill						
<input type="checkbox"/> Slope						
<input checked="" type="checkbox"/> Upland						
<input type="checkbox"/> Valley						
		20. Water well contractor's certification:				
		This well was drilled under my jurisdiction and this report is true to the best of my knowledge and belief.				
		Joe's Well Service 179				
		Business name Box 174 Cimarron, Ks.				
		Address Box 174 Cimarron, Ks.				
		Signed Larry Crick Date 3-21-77				
		Authorized representative				

Forward the white, blue and pink copies to the Department of Health and Environment

Form WWC-5