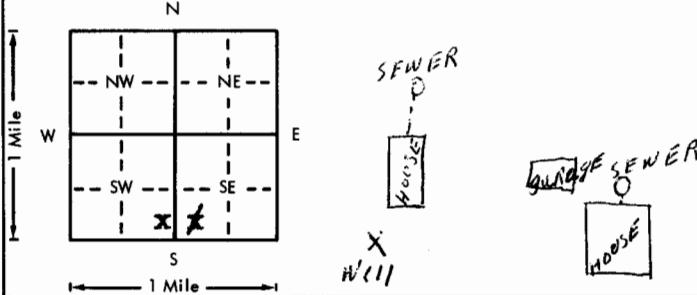


USE TYPEWRITER OR BALL
POINT PEN-PRESS FIRMLY,
PRINT CLEARLY.

WATER WELL RECORD
KSA 82a-1201-1215

Kansas Department of Health and
Environment-Division of Environment
(Water well Contractors)
Topeka, Kansas 66620

1. Location of well:	County	Fraction	Section number	Township number	Range number	
Gray	SE 1/4 SE 1/4 SW 1/4	#25	T #28 S 1/4 R #27 W			
2. Distance and direction from nearest town or city: 5 miles South of Ensign, Ks. Street address of well location if in city:	3. Owner of well: Ralph Hamilton					
4. Locate with "X" in section below: 	Sketch map:					
5. Type and color of material	From	To	6. Bore hole dia. 8 in. Completion date 11-14-75 Well depth 187 ft.			
Top soil & Clay	0	15	7. <input checked="" type="checkbox"/> Cable tool <input checked="" type="checkbox"/> Rotary <input type="checkbox"/> Driven <input type="checkbox"/> Dug <input type="checkbox"/> Hollow rod <input type="checkbox"/> Jetted <input type="checkbox"/> Bored <input type="checkbox"/> Reverse rotary			
Clay	15	75	8. Use: <input checked="" type="checkbox"/> Domestic <input type="checkbox"/> Public supply <input type="checkbox"/> Industry <input type="checkbox"/> Irrigation <input type="checkbox"/> Air conditioning <input type="checkbox"/> Stock <input type="checkbox"/> Lawn <input type="checkbox"/> Oil field water <input type="checkbox"/> Other			
Brown sandy clay	75	90	9. Casing: Material RMP Height: Above or 12 in. Threaded <input type="checkbox"/> Welded <input type="checkbox"/> Surface 12 in. RMP <input checked="" type="checkbox"/> PVC Weight lbs./ft. Dia. 5 in. to 187 ft. depth Wall Thickness, inches or Dia. in. to ft. depth gage No. 250			
Red clay	90	105	10. Screen: Manufacturer's name Jess & Lowell Type RMP Dia. 5 in. Slot/gauze 1/8 in. Length 20 ft. Set between 162 ft. and 182 ft. ft. and ft. Gravel pack? yes Size range of material 1 in.			
Red clay & medium sand	105	120	11. Static water level: 135 ft. below land surface Date 11-14-75 mo./day/yr.			
Medium to coarse sand	120	135	12. Pumping level below land surfaces: 141 ft. after 12 hrs. pumping 30 g.p.m. ft. after hrs. pumping g.p.m. Estimated maximum yield 50 g.p.m.			
Coarse & 8 ft. rock	135	150	13. Water sample submitted: mo./day/yr. Yes <input checked="" type="checkbox"/> No Date			
Medium to coarse sand	150	165	14. Well head completion: <input checked="" type="checkbox"/> Pitless adapter 12 inches above grade			
medium to coarse sand & clay	165	180	15. Well grouted? yes With: <input checked="" type="checkbox"/> Neat cement <input type="checkbox"/> Bentonite <input type="checkbox"/> Concrete Depth: From 14 ft. to 15 ft.			
Clay & medium sand & clay	180	195	16. Nearest source of possible contamination: 300 ft. Direction NE Type Sewer System Well disinfected upon completion? <input checked="" type="checkbox"/> Yes <input type="checkbox"/> No			
(Use a second sheet if needed)			17. Pump: Not installed Manufacturer's name F & W Model number 15BK12 HP 1/2 Volts 230 Length of drop pipe 168 ft. capacity 18 g.p.m. Type: <input checked="" type="checkbox"/> Submersible <input type="checkbox"/> Turbine <input type="checkbox"/> Jet <input type="checkbox"/> Reciprocating <input type="checkbox"/> Centrifugal <input type="checkbox"/> Other			
18. Elevation:	19. Remarks:					20. Water well contractor's certification: This well was drilled under my jurisdiction and this report is true to the best of my knowledge and belief. JOE'S WELL SERVICE 179 Business name <input type="checkbox"/> Box 174 Cimarron, Ks. License No. Address <input type="checkbox"/> Signed <input type="checkbox"/> Date 12-20-75 Signed <input type="checkbox"/> Authorized representative