


1 LOCATION OF WATER WELL: County: <b>Gray</b>	Fraction <b>NW ¼ NE ¼ NW ¼</b>	Section Number <b>7</b>	Township Number <b>T 28 S</b>	Range Number <b>R 27 E/W</b>
--	-----------------------------------	----------------------------	----------------------------------	---------------------------------

Distance and direction from nearest town or city street address of well if located within city?

**Highway 56, Haggard**

2 WATER WELL OWNER: **Dodge City Coop**  
 RR#, St. Address, Box # : **RR 2, Highway 56**  
 City, State, ZIP Code : **Haggard, Kansas 67835**  
 Board of Agriculture, Division of Water Resources  
 Application Number:

3 LOCATE WELL'S LOCATION WITH AN "X" IN SECTION BOX:

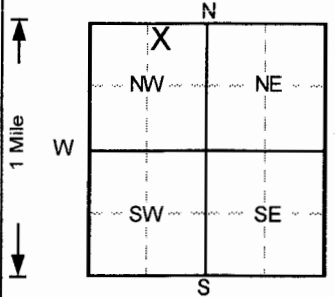

4 DEPTH OF COMPLETED WELL ..... **218** ..... ft. ELEVATION: .....

Depth(s) Groundwater Encountered 1. .... ft. 2. .... ft. 3. .... ft.

WELL'S STATIC WATER LEVEL ..... ft. below land surface measured on mo/day/yr .....

Pump test data: Well water was ..... **NA** ..... ft. after ..... hours pumping ..... gpm

Est. Yield .. **NA** .. gpm: Well water was ..... ft. after ..... hours pumping ..... gpm

Bore Hole Diameter ..... **11** ..... in. to ..... **225** ..... ft., and ..... in. to ..... ft.

WELL WATER TO BE USED AS: 5 Public water supply 8 Air conditioning 11 Injection well  
 1 Domestic 3 Feedlot 6 Oil field water supply 9 Dewatering 12 Other (Specify below)  
 2 Irrigation 4 Industrial 7 Lawn and garden only **10** Monitoring well

Was a chemical/bacteriological sample submitted to Department? Yes.....No  ; If yes, mo/day/yr sample was submitted

Water Well Disinfected? Yes No

5 TYPE OF BLANK CASING USED:

1 Steel	3 RMP (SR)	5 Wrought iron	8 Concrete tile	CASING JOINTS: Glued ..... Clamped .....
<b>2</b> PVC	4 ABS	6 Asbestos-Cement	9 Other (specify below)	Welded .....
		7 Fiberglass		Threaded. <input checked="" type="checkbox"/>

Blank casing diameter ..... **6** ..... in. to ..... **188** ..... ft., Dia ..... in. to ..... ft., Dia ..... in. to ..... ft.

Casing height above land surface ..... in., weight ..... lbs./ft. Wall thickness or gauge No. .... **Sch. 40** .....

TYPE OF SCREEN OR PERFORATION MATERIAL

1 Steel	3 Stainless steel	5 Fiberglass	<b>7</b> PVC	10 Asbestos-cement
2 Brass	4 Galvanized steel	6 Concrete tile	8 RMP (SR)	11 Other (specify) .....
			9 ABS	12 None used (open hole)

SCREEN OR PERFORATION OPENINGS ARE:

1 Continuous slot	<b>3</b> Mill slot	5 Gauzed wrapped	8 Saw cut	11 None (open hole)
2 Louvered shutter	4 Key punched	6 Wire wrapped	9 Drilled holes	
		7 Torch cut	10 Other (specify) .....	

SCREEN-PERFORATED INTERVALS: From ..... **188** ..... ft. to ..... **218** ..... ft., From ..... ft. to ..... ft.

GRAVEL PACK INTERVALS: From ..... **180** ..... ft. to ..... **225** ..... ft., From ..... ft. to ..... ft.

6 GROUT MATERIAL: 1 Neat cement **2** Cement grout **3** Bentonite 4 Other .....

Grout Intervals: From ..... **3** ..... ft. to ..... **6** ..... ft., From ..... **6** ..... ft. to ..... **175** ..... ft., From ..... **175** ..... ft. to ..... **180** ..... ft.

What is the nearest source of possible contamination:

1 Septic tank	4 Lateral lines	7 Pit privy	10 Livestock pens	14 Abandoned water well
2 Sewer lines	5 Cess pool	8 Sewage lagoon	11 Fuel storage	15 Oil well/Gas well
3 Watertight sewer lines	6 Seepage pit	9 Feedyard	12 Fertilizer storage	16 Other (specify below)
			13 Insecticide storage	

Direction from well? How many feet?

FROM	TO	LITHOLOGIC LOG	FROM	TO	PLUGGING INTERVALS
0	0.5	Gravel,	217	220	Caliche, sandy,
0.5	3	Clay, Dark Gray Brown	220	225	Clay, v. sandy w/caliche, Lt. Red Brown
3	7	Clay, silty, Brown			
7	48	Clay, v. silty, Lt. Brown			
48	55	Clay, sandy (vf), V. Lt. Brown			
55	85	Clay, sandy (vf), V. Lt. Brown to Tan w/white			
85	100	Clay, occ. caliche, V. Lt. Brown			
100	120	Silt, occ. caliche, decr. sand, Lt. Brown			
120	165	Clay, rare sand lenses, silty, V. Lt. Brown w/o			
165	182	Sand (vf), clayey, Lt. Brown			
182	187	Sand (vf-c), subrounded, tr. f gravel,			
187	203	Clay, sl. sandy w/occ. thin sand lenses, V. Lt. B			
203	208	Clay, occ. sand lenses, Lt. Gray Brown			RW1
208	212	Sand (f-c) w/f gravel,			
212	217	Clay, sandy (vf), Lt. Red Brown			

7 CONTRACTOR'S OR LANDOWNER'S CERTIFICATION: This water well was **(1)** constructed, (2) reconstructed, or (3) plugged under my jurisdiction and was completed on (mo/day/year) ..... **9/8/2009** ..... and this record is true to the best of my knowledge and belief.

Kansas Water Well Contractor's License No. .... **527** ..... This Water Well Record was completed on (mo/day/yr) ..... **9/21/2009** ..... under the business name of **GeoCore, Inc.** by (signature) *Dale Kolt*

OFFICE USE ONLY  
T  
R  
EM  
SEC  
1/4  
1/4  
1/4