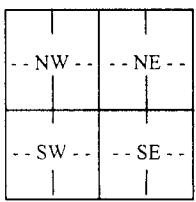


WATER WELL RECORD

Form WWC-5

Division of Water Resources App. No.

| | | | | |
|--|---|---|-------------------------------|--|
| 1 LOCATION OF WATER WELL: County: <u>Gray</u> | Fraction <u>1/4 NE 1/4 SW 1/4 NW 1/4</u> | Section Number <u>6</u> | Township No. T <u>28</u> S | Range Number R <u>27</u> <input type="checkbox"/> E <input checked="" type="checkbox"/> W |
| Street/Rural Address of Well Location; if unknown, distance & direction from nearest town or intersection: If at owner's address, check here <input checked="" type="checkbox"/> | | Global Positioning System (GPS) information: Latitude: (in decimal degrees) Longitude: (in decimal degrees) Elevation: Datum: <input type="checkbox"/> WGS 84, <input type="checkbox"/> NAD 83, <input type="checkbox"/> NAD 27 Collection Method: <input type="checkbox"/> GPS unit (Make/Model:) <input type="checkbox"/> Digital Map/Photo, <input type="checkbox"/> Topographic Map, <input type="checkbox"/> Land Survey Est. Accuracy: <input type="checkbox"/> <3 m, <input type="checkbox"/> 3-5 m, <input type="checkbox"/> 5-15 m, <input type="checkbox"/> >15 m | | |
| 2 WATER WELL OWNER: <u>Michelle Hammond</u> RR#, Street Address, Box #: <u>25402 19 Rd.</u> City, State, ZIP Code: <u>Cimarron, KS 67835</u> | | | | |

| | |
|--|--|
| 3 LOCATE WELL WITH AN "X" IN SECTION BOX: N  E S ----- mile ----- | 4 DEPTH OF COMPLETED WELL <u>270</u> ft. Depth(s) Groundwater Encountered (1)..... ft. (2)..... ft. (3)..... ft. WELL'S STATIC WATER LEVEL..... <u>230</u> ft. below land surface measured on mo/day/yr... <u>8/16/14</u> Pump test data: Well water was..... ft. after..... hours pumping..... gpm EST. YIELD..... gpm. Well water was..... ft. after..... hours pumping..... gpm Bore Hole Diameter <u>978</u> in. to <u>270</u> ft., and in. to ft. WELL WATER TO BE USED AS: <input type="checkbox"/> Public water supply <input type="checkbox"/> Geothermal <input type="checkbox"/> Injection well <input checked="" type="checkbox"/> Domestic <input type="checkbox"/> Feedlot <input type="checkbox"/> Oil field water supply <input type="checkbox"/> Dewatering <input type="checkbox"/> Other (Specify below) <input type="checkbox"/> Irrigation <input type="checkbox"/> Industrial <input type="checkbox"/> Domestic-lawn & garden <input type="checkbox"/> Monitoring well Was a chemical/bacteriological sample submitted to Department? <input type="checkbox"/> Yes <input checked="" type="checkbox"/> No If yes, mo/day/yr sample was submitted..... Water well disinfected? <input checked="" type="checkbox"/> Yes <input type="checkbox"/> No |
|--|--|

5 TYPE OF CASING USED: Steel PVC Other

CASING JOINTS: Glued Clamped Welded Threaded

Casing diameter 5 in. to 270 ft., Diameter in. to ft., Diameter in. to ft.
Casing height above land surface..... 12 in., Weight lbs./ft., Wall thickness or gauge No. SOR 21

TYPE OF SCREEN OR PERFORATION MATERIAL:
 Steel Stainless Steel PVC Other (Specify)
 Brass Galvanized Steel None used (open hole)

SCREEN OR PERFORATION OPENINGS ARE:
 Continuous slot Mill slot Gauze wrapped Torch cut Drilled holes None (open hole)
 Louvered shutter Key punched Wire wrapped Saw cut Other (specify)

SCREEN-PERFORATED INTERVALS: From..... 210 ft. to 270 ft., From ft. to ft.
From..... ft. to ft., From ft. to ft.
GRAVEL PACK INTERVALS: From..... 24 ft. to 270 ft., From ft. to ft.
From..... ft. to ft., From ft. to ft.


6 GROUT MATERIAL: Neat cement Cement grout Bentonite Other

Grout Intervals: From 4 ft. to 24 ft., From ft. to ft., From ft. to ft.

What is the nearest source of possible contamination:
 Septic tank Lateral lines Pit privy Livestock pens Insecticide storage Other (specify below)
 Sewer lines Cesspool Sewage lagoon Fuel storage Abandoned water well
 Watertight sewer lines Seepage pit Feedyard Fertilizer storage Oil well/gas well

Direction from well north Distance from well 54'

| FROM | TO | LITHOLOGIC LOG | FROM | TO | LITHO. LOG (cont.) or PLUGGING INTERVALS |
|------------|------------|-----------------------|------|----|--|
| <u>0</u> | <u>185</u> | <u>Tan Clay</u> | | | |
| <u>185</u> | <u>189</u> | <u>Med. Sand</u> | | | |
| <u>189</u> | <u>200</u> | <u>Tan Sandy clay</u> | | | |
| <u>200</u> | <u>270</u> | <u>Med. Sand</u> | | | |
| | | | | | |
| | | | | | |
| | | | | | |
| | | | | | |
| | | | | | |

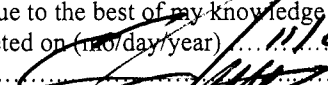7 CONTRACTOR'S OR LANDOWNER'S CERTIFICATION: This water well was constructed, reconstructed, or plugged under my jurisdiction and was completed on (mo/day/year) .. 8/16/14 ... and this record is true to the best of my knowledge and belief.
Kansas Water Well Contractor's License No. 533 This Water Well Record was completed on (mo/day/year) .. 11/6/14 ..
under the business name of Santzen Water Well by (signature) .. 

INSTRUCTIONS: Use typewriter or ball point pen. PLEASE PRESS FIRMLY and PRINT clearly. Please fill in blanks and check the correct answers. Send three copies (white, blue, pink) to Kansas Department of Health and Environment, Bureau of Water, Geology Section, 1000 SW Jackson St., Suite 420, Topeka, Kansas 66612-1367. Telephone 785-296-5524. Send one copy to WATER WELL OWNER and retain one for your records. Include fee of \$5.00 for each constructed well. Visit us at <http://www.kdheks.gov/waterwell/index.html>.