



CORRECTED

WATER WELL RECORD Form WWC-5

Division of Water Resources App. No.


7751

Well ID

Original Record Correction Change in Well Use

1 LOCATION OF WATER WELL: County: Gray Fraction NW 1/4 NW 1/4 NW 1/4 NE 1/4 Section Number 4 Township Number T 28 S Range Number R 27 E W

2 WELL OWNER: Last Name: SAYRE First: STEPHEN I Street or Rural Address where well is located (if unknown, distance and direction from nearest town or intersection): FROM HWY 56, NORTH ON ROAD 22 .4 MILES, WEST ON Y RD 1/2 MILE, INTO SOUTH FIELD 85 FT.

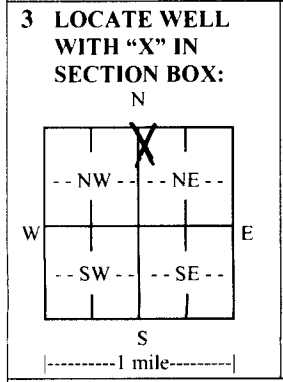

3 LOCATE WELL WITH 'X' IN SECTION BOX: 4 DEPTH OF COMPLETED WELL: 271 ft. Depth(s) Groundwater Encountered: 1) 226 ft. 2) 216 ft. 3) 216 ft. or 4) Dry Well WELL'S STATIC WATER LEVEL: 216 ft. below land surface, measured on (mo-day-yr) 11/24/2015

5 Latitude: 37.649811 (decimal degrees) Longitude: 100.279111 (decimal degrees) Datum: WGS 84 NAD 83 NAD 27 Source for Latitude/Longitude: GPS (unit make/model: ) (WAAS enabled? Yes No) Land Survey Topographic Map Online Mapper:

6 Elevation: 2758 ft. Ground Level TOC Source: Land Survey GPS Topographic Map Other KOLAR

7 WELL WATER TO BE USED AS: 1. Domestic: Household Lawn & Garden Livestock Irrigation Feedlot Industrial 2. Public Water Supply: well ID 3. Dewatering: how many wells? 4. Aquifer Recharge: well ID 5. Monitoring: well ID 6. Environmental Remediation: well ID Air Sparge Soil Vapor Extraction Recovery Injection 7. Oil Field Water Supply: lease 8. Test Hole: well ID Cased Uncased Geotechnical 9. Geothermal: how many bores? a) Closed Loop Horizontal Vertical b) Open Loop Surface Discharge Inj. of Water 10. Other (specify):

Was a chemical/bacteriological sample submitted to KDHE? Yes No If yes, date sample was submitted: Water well disinfected? Yes No

8 TYPE OF CASING USED: Steel PVC Other CASING JOINTS: Glued Clamped Welded Threaded Casing diameter 16 in. to 21.5 ft., Diameter 16 in. to 27.1 ft., Diameter in. to ft. Casing height above land surface 12 in. Weight lbs./ft. Wall thickness or gauge No. 250 6.16

TYPE OF SCREEN OR PERFORATION MATERIAL: Steel Stainless Steel Fiberglass PVC Brass Galvanized Steel Concrete tile None used (open hole) Other (Specify)

SCREEN OR PERFORATION OPENINGS ARE: Continuous Slot Mill Slot Gauze Wrapped Torch Cut Drilled Holes Other (Specify) Louvered Shutter Key Punched Wire Wrapped Saw Cut None (Open Hole)

SCREEN-PERFORATED INTERVALS: From 215 ft. to 255 ft., From ft. to ft., From ft. to ft. GRAVEL PACK INTERVALS: From 20 ft. to 27.1 ft., From ft. to ft., From ft. to ft.

9 GROUT MATERIAL: Neat cement Cement grout Bentonite Other Grout Intervals: From 0 ft. to 20 ft., From ft. to ft., From ft. to ft., From ft. to ft.

Nearest source of possible contamination: Septic Tank Lateral Lines Pit Privy Livestock Pens Insecticide Storage Sewer Lines Cess Pool Sewage Lagoon Fuel Storage Abandoned Water Well Watertight Sewer Lines Seepage Pit Feedyard Fertilizer Storage Oil Well/Gas Well Other (Specify)

Direction from well? Distance from well? ft.

Table with columns: FROM, TO, LITHOLOGIC LOG, FROM, TO, LITHO. LOG (cont.) or PLUGGING INTERVALS. Rows include TOPSOIL, SC/LIMESTONE/SAND, SAND & CLAY, SANDY CLAY & LIMESTONE, SANDY CLAY/F/M SAND & SS, F/M SAND/CLAY/LS/GRAVEL, C SAND & GRAVEL, C. SAND /GRAVEL & ROCKS, CLAY & SHALE. Includes a Notes column.

11 CONTRACTOR'S OR LANDOWNER'S CERTIFICATION: This water well was constructed, reconstructed, or plugged under my jurisdiction and was completed on (mo-day-year) 11/10/2015 and this record is true to the best of my knowledge and belief. Kansas Water Well Contractor's License No. 748 This Water Well Record was completed on (mo-day-year) 12/18/2015 under the business name of Downey Drilling, Inc.