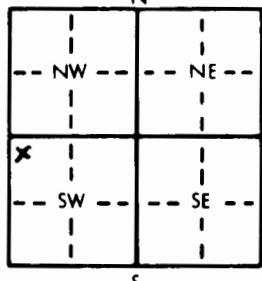
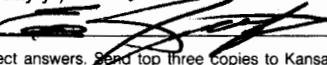


LOCATION OF WATER WELL:		Fraction <b>NW 1/4 NW 1/4 SW 1/4</b>	Section Number <b>21</b>	Township Number <b>T 28 S</b>	Range Number <b>R 28 E</b>
Distance and direction from nearest town or city street address of well if located within city? <b>From Montezuma, 2 miles east on Hwy. 56, then 1 mile south</b>					
2 WATER WELL OWNER: <b>Evan Koch</b>		Board of Agriculture, Division of Water Resources Application Number:			
RR#, St. Address, Box #: <b>28706 12 Rd.</b>					
City, State, ZIP Code: <b>Montezuma, KS 67867</b>					
3 LOCATE WELL'S LOCATION WITH AN "X" IN SECTION BOX:		4 DEPTH OF COMPLETED WELL... <b>200</b> ft. ELEVATION: .....			
		Depth(s) Groundwater Encountered 1..... ft. 2..... ft. 3..... ft. WELL'S STATIC WATER LEVEL <b>120</b> ft. below land surface measured on mo/day/yr <b>7-24-87</b> Pump test data: Well water was ..... ft. after ..... hours pumping ..... gpm Est. Yield ..... gpm: Well water was ..... ft. after ..... hours pumping ..... gpm Bore Hole Diameter <b>9 7/8</b> in. to <b>200</b> ft. and ..... in. to ..... ft. WELL WATER TO BE USED AS: 5 Public water supply 8 Air conditioning 11 Injection well 6 Feedlot 9 Oil field water supply 10 Dewatering 12 Other (Specify below) 7 Irrigation 4 Industrial 7 Lawn and garden only 10 Monitoring well Was a chemical/bacteriological sample submitted to Department? Yes..... No <b>X</b> ; If yes, mo/day/yr sample was submitted Water Well Disinfected? Yes <b>X</b> No			
5 TYPE OF BLANK CASING USED:		5 Wrought iron	8 Concrete tile	CASING JOINTS: Glued <b>X</b> Clamped .....	
1 Steel	3 RMP (SR)	6 Asbestos-Cement	9 Other (specify below)	Welded .....	
<b>2 PVC</b>	4 ABS	7 Fiberglass		Threaded.	
Blank casing diameter <b>5"</b> in. to <b>140</b> ft., Dia .....		in. to .....	ft., Dia .....	in. to .....	ft.
Casing height above land surface <b>12</b> in., weight .....		lbs./ft. Wall thickness or gauge No. <b>SDR 21</b>			
TYPE OF SCREEN OR PERFORATION MATERIAL:					
1 Steel	3 Stainless steel	5 Fiberglass	8 RMP (SR)	10 Asbestos-cement	
2 Brass	4 Galvanized steel	6 Concrete tile	9 ABS	11 Other (specify) .....	
SCREEN OR PERFORATION OPENINGS ARE:					
1 Continuous slot	3 Mill slot	5 Gauzed wrapped	<b>7 PVC</b>	12 None used (open hole)	
2 Louvered shutter	4 Key punched	6 Wire wrapped	<b>9 Drilled holes</b>	11 None (open hole)	
SCREEN-PERFORATED INTERVALS: From <b>140</b> ft. to <b>200</b> ft., From .....					
From .....					
GRAVEL PACK INTERVALS: From <b>24</b> ft. to <b>200</b> ft., From .....					
From .....					

6 GROUT MATERIAL:		1 Neat cement	2 Cement grout	<b>Bentonite</b>	4 Other .....
Grout Intervals: From <b>4</b> ft. to <b>24</b> ft., From .....					
What is the nearest source of possible contamination:					
1 Septic tank	4 Lateral lines	7 Pit privy	<b>10 Livestock pens</b>	14 Abandoned water well	
2 Sewer lines	5 Cess pool	8 Sewage lagoon	<b>11 Fuel storage</b>	15 Oil well/Gas well	
3 Watertight sewer lines	6 Seepage pit	9 Feedyard	<b>12 Fertilizer storage</b>	16 Other (specify below)	
13 Insecticide storage					

FROM	TO	LITHOLOGIC LOG	FROM	TO	PLUGGING INTERVALS
<b>0</b>	<b>1</b>	<b>Topsoil</b>			
<b>1</b>	<b>83</b>	<b>Brown clay + caliche layers</b>			
<b>83</b>	<b>100</b>	<b>Brown sandy clay</b>			
<b>100</b>	<b>119</b>	<b>Brown sandy clay + white rock ledges</b>			
<b>119</b>	<b>122</b>	<b>White rock</b>			
<b>122</b>	<b>140</b>	<b>Brown sandy clay + white rock ledges</b>			
<b>140</b>	<b>165</b>	<b>Med. sand</b>			
<b>165</b>	<b>184</b>	<b>Brown Sandy clay</b>			
<b>184</b>	<b>185</b>	<b>Med. sand (loose)</b>			
<b>185</b>	<b>238</b>	<b>Brown sandy + white rock ledges</b>			

7 CONTRACTOR'S OR LANDOWNER'S CERTIFICATION: This water well was <b>(1) constructed</b> , <b>(2) reconstructed</b> , or <b>(3) plugged</b> under my jurisdiction and was completed on (mo/day/year) <b>7-24-87</b> and this record is true to the best of my knowledge and belief. Kansas Water Well Contractor's License No. <b>533</b> This Water Well Record was completed on (mo/day/yr) <b>9-22-87</b> under the business name of <b>Jantzen Water Well Repair</b> by (signature) 					
--	--	--	--	--	--