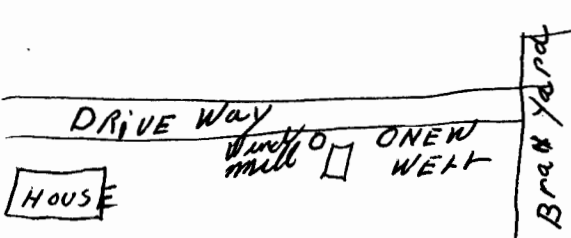


USE TYPEWRITER OR BALL
POINT PEN-PRESS FIRMLY,
PRINT CLEARLY.

WATER WELL RECORD
KSA 82a-1201-1215

Kansas Department of Health and
Environment-Division of Environment
(Water well Contractors)
Topeka, Kansas 66620

1. Location of well:	County Gray	Fraction NW 1/4 NW 1/4 NW/4	Section number 7	Township number T 28 S R 28 E/W	Range number		
2. Distance and direction from nearest town or city: 2 1/2 miles North of Montezuma, Kansas Street address of well location if in city:			3. Owner of well: John Paul Unruh R.R. or street: City, state, zip code: Montezuma, Kansas 67867				
4. Locate with "X" in section below: <div style="text-align: center;">N 1 Mile W E S 1 Mile</div>		Sketch map: 		6. Bore hole dia. 8 in. Completion date 2-22-79 Well depth 236 ft.			
5. Type and color of material		From		To		7. <input checked="" type="checkbox"/> Cable tool <input checked="" type="checkbox"/> Rotary <input type="checkbox"/> Driven <input type="checkbox"/> Dug <input type="checkbox"/> Hollow rod <input type="checkbox"/> Jetted <input type="checkbox"/> Bored <input type="checkbox"/> Reverse rotary	
						8. Use: <input checked="" type="checkbox"/> Domestic <input type="checkbox"/> Public supply <input type="checkbox"/> Industry <input type="checkbox"/> Irrigation <input type="checkbox"/> Air conditioning <input type="checkbox"/> Stock <input type="checkbox"/> Lawn <input type="checkbox"/> Oil field water <input type="checkbox"/> Other	
Top soil & clay		0		15		9. Casing: Material RMP Height: Above XXXX Threaded <input type="checkbox"/> Welded <input type="checkbox"/> Surface 12 in. RMP XX PVC <input type="checkbox"/> Weight <input type="checkbox"/> lbs./ft. Dia. 5 in. to 236 ft. depth Wall Thickness: inches or Dia. <input type="checkbox"/> in. to <input type="checkbox"/> ft. depth gage No. 250	
Clay		15		30		10. Screen: Manufacturer's name Jess & Lowe Type RMP Dia. 5" Slot/gauze 1/8" Length 30 ft. Set between 200 ft. and 230 ft. <input type="checkbox"/> ft. and <input type="checkbox"/> ft. Gravel pack? yes Size range of material 1/4"	
Clay & fine sand		30		45		11. Static water level: <input type="checkbox"/> mo./day/yr. 130 ft. below land surface Date 2-22-79	
Fine sand & Clay		45		60		12. Pumping level below land surfaces: 236 ft. after 1 hrs. pumping 15 g.p.m. <input type="checkbox"/> ft. after <input type="checkbox"/> hrs. pumping <input type="checkbox"/> g.p.m. Estimated maximum yield 22 g.p.m.	
Clay & Fine sand (mixed cleache)		60		75		13. Water sample submitted: <input type="checkbox"/> Yes <input checked="" type="checkbox"/> No Date <input type="checkbox"/> mo./day/yr.	
Cleachie & Medium sand (dry)		75		90		14. Well head completion: <input checked="" type="checkbox"/> Pitless adapter 12 inches above grade	
Medium sand (dry)		90		105		15. Well grouted? yes With: <input checked="" type="checkbox"/> Neat cement <input type="checkbox"/> Bentonite <input type="checkbox"/> Concrete Depth: From 7 ft. to 20 ft.	
Medium sand (dry) clay 2ft. & medium sand		105		120		16. Nearest source of possible contamination: Barn ft. 75 Direction East Type Yard Well disinfected upon completion? <input checked="" type="checkbox"/> Yes <input type="checkbox"/> No	
Medium sand		120		135		17. Pump: <input type="checkbox"/> Not installed Manufacturer's name Goulds Model number 108J HP 1 Volts 230 Length of drop pipe 210 ft. capacity 10 g.p.m. Type: <input checked="" type="checkbox"/> Submersible <input type="checkbox"/> Turbine <input type="checkbox"/> Jet <input type="checkbox"/> Reciprocating <input type="checkbox"/> Centrifugal <input type="checkbox"/> Other	
Medium sand (3 ft.) & clay		135		150		20. Water well contractor's certification: This well was drilled under my jurisdiction and this report is true to the best of my knowledge and belief. Joe's Well Service 179 Business name License No. Address Box 174 Cimarron, Ks. Signed Larry L. Crick Date 5-9-79 Authorized representative	
Clay & fine to medium sand		150		165			
Medium sand & clay		165		180			
Clay		180		195			
Clay & white rock		195		210			
Clay & fine to medium sand		210		225			
Fine to medium sand & clay		225		240			
Clay		240		255			
Clay & rock layers - Blue shale		255		270			
18. Elevation:		19. Remarks: Has excellent drainage to the East					
Topography: <input type="checkbox"/> Hill <input checked="" type="checkbox"/> Slope <input type="checkbox"/> Upland <input type="checkbox"/> Valley							

Forward the white, blue and pink copies to the Department of Health and Environment

Form WWC-5