


1 LOCATION OF WATER WELL: Fraction NE 1/4 NE 1/4 SE 1/4 Section Number 1 Township Number T 28 S Range Number R 28 E/W

Distance and direction from nearest town or city street address of well if located within city?  
 1/2 Mile west 3/4 Mile North of Haggard

2 WATER WELL OWNER: Bill Good  
 RR#, St. Address, Box #: Routel Box 39 Board of Agriculture, Division of Water Resources  
 City, State, ZIP Code: Montezuma, Kansas 67867 Application Number:

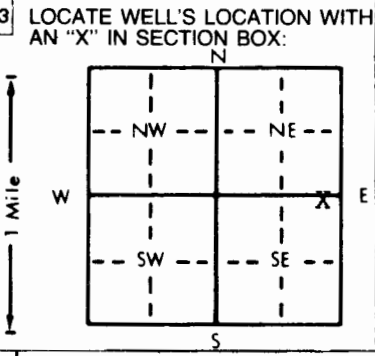

4 DEPTH OF COMPLETED WELL: 244 ft. ELEVATION:  
 Depth(s) Groundwater Encountered 1. 195 ft. 2. 220 ft. 3. ft.  
 WELL'S STATIC WATER LEVEL 195 ft. below land surface measured on mo/day/yr 9-27-94  
 Pump test data: Well water was ft. after hours pumping gpm  
 Est. Yield 10 gpm Well water was ft. after hours pumping gpm  
 Bore Hole Diameter 10 in. to 244 ft., and in. to ft.  
 WELL WATER TO BE USED AS: 5 Public water supply 8 Air conditioning 11 Injection well  
 1 Domestic 3 Feedlot 6 Oil field water supply 9 Dewatering 12 Other (Specify below)  
 2 Irrigation 4 Industrial 7 Lawn and garden only 10 Monitoring well  
 Was a chemical/bacteriological sample submitted to Department? Yes No X; If yes, mo/day/yr sample was submitted  
 Water Well Disinfected? Yes X No

5 TYPE OF BLANK CASING USED: 5 Wrought iron 8 Concrete tile CASING JOINTS: Glued X Clamped  
 1 Steel 3 RMP (SR) 6 Asbestos-Cement 9 Other (specify below) Welded  
 2 PVC 4 ABS 7 Fiberglass Threaded  
 Blank casing diameter 5 in. to 0-224 ft., Dia in. to ft., Dia in. to ft.  
 Casing height above land surface 24 in., weight lbs./ft. Wall thickness or gauge No. 316  
 TYPE OF SCREEN OR PERFORATION MATERIAL: 7 PVC 10 Asbestos-cement  
 1 Steel 3 Stainless steel 5 Fiberglass 8 RMP (SR) 11 Other (specify)  
 2 Brass 4 Galvanized steel 6 Concrete tile 9 ABS 12 None used (open hole)  
 SCREEN OR PERFORATION OPENINGS ARE: 5 Gauzed wrapped 8 Saw cut 11 None (open hole)  
 1 Continuous slot 3 Mill slot 6 Wire wrapped 9 Drilled holes  
 2 Louvered shutter 4 Key punched 7 Torch cut 10 Other (specify)  
 SCREEN-PERFORATED INTERVALS: From 224 ft. to 244 ft., From ft. to ft.  
 GRAVEL PACK INTERVALS: From 20 ft. to 244 ft., From ft. to ft.

6 GROUT MATERIAL: 1 Neat cement 2 Cement grout 3 Bentonite 4 Other  
 Grout Intervals: From 20 ft. to 0 ft., From ft. to ft. to 0 ft. to 20 ft.  
 What is the nearest source of possible contamination:  
 1 Septic tank 4 Lateral lines 7 Pit privy 10 Livestock pens 14 Abandoned water well  
 2 Sewer lines 5 Cess pool 8 Sewage lagoon 11 Fuel storage 15 Oil well/Gas well  
 3 Watertight sewer lines 6 Seepage pit 9 Feedyard 12 Fertilizer storage 16 Other (specify below)  
 13 Insecticide storage  
 Direction from well? 80' to be plugged How many feet? East

FROM	TO	LITHOLOGIC LOG	FROM	TO	PLUGGING INTERVALS
0	75	Topsoil & clay & little sand			
75	120	Clay			
120	165	Clay & little lime			
165	180	Clay & little lime (very hard)			
180	195	Clay (gummy)			
195	229	Sand & clay			
229	236	Clay & Lime (Very hard)			
236	244	Shale			

7 CONTRACTOR'S OR LANDOWNER'S CERTIFICATION: This water well was (1) constructed, (2) reconstructed, or (3) plugged under my jurisdiction and was completed on (mo/day/year) 9-28-94 and this record is true to the best of my knowledge and belief. Kansas Water Well Contractor's License No. 223 This Water Well Record was completed on (mo/day/yr) 10-10-94 under the business name of Dunham Drilling Co. by (signature) Karen Dunham

INSTRUCTIONS: Use typewriter or ball point pen PLEASE PRESS FIRMLY and PRINT clearly. Please fill in blanks, underline or circle the correct answers. Send top three copies to Kansas Department of Health and Environment, Bureau of Water, Topeka, Kansas 66620-0001. Telephone: 913-296-5545. Send one to WATER WELL OWNER and retain one for your records.

OFFICE USE ONLY  
T  
R  
EW  
SEC.