

WATER WELL RECORD Form WWC-5 KSA 82a-1212

1 LOCATION OF WATER WELL:	Fraction NW 1/4 NW 1/4 SE 1/4	Section Number 17	Township Number T 28 S	Range Number R 29 E
---------------------------	----------------------------------	----------------------	---------------------------	------------------------

County: Gray Distance and direction from nearest town or city street address of well if located within city?

2 Miles West 3½ Mile North of Montezuma,


2 WATER WELL OWNER: David Robertson

RR#, St. Address, Box #: 27605 9 Rd

Board of Agriculture, Division of Water Resources

City, State, ZIP Code: Montezuma, Kansas 67867 Application Number:

3 LOCATE WELL'S LOCATION WITH AN "X" IN SECTION BOX:

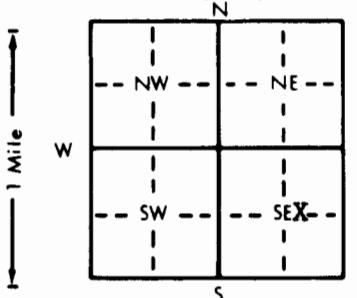

4 DEPTH OF COMPLETED WELL... 330 ft. ELEVATION:

Depth(s) Groundwater Encountered 1... 240 ft. 2... 251 ft. 3... 285 ft.

WELL'S STATIC WATER LEVEL... 236 ft. below land surface measured on mo/day/yr... 5-31-96

Pump test data: Well water was ft. after hours pumping gpm

Est. Yield 10 gpm: Well water was ft. after hours pumping gpm

Bore Hole Diameter... 10 in. to 330 ft., and in. to ft.

WELL WATER TO BE USED AS: 5 Public water supply 8 Air conditioning 11 Injection well

1 Domestic 3 Feedlot 6 Oil field water supply 9 Dewatering 12 Other (Specify below)

2 Irrigation 4 Industrial 7 Lawn and garden only 10 Monitoring well

Was a chemical/bacteriological sample submitted to Department? Yes..... No. If yes, mo/day/yr sample was submittedWater Well Disinfected? Yes No

5 TYPE OF BLANK CASING USED:

1 Steel 3 RMP (SR)

5 Wrought iron

8 Concrete tile

CASING JOINTS: Glued Clamped

2 PVC 4 ABS

6 Asbestos-Cement

7 Fiberglass

9 Other (specify below)

Welded

Threaded

Blank casing diameter... 5 in. to 250 ft., Dia... 5 in. to 270 ft. 290 ft., Dia... 5 in. to 295 ft. 330 ft.

Casing height above land surface... 12 in., weight lbs./ft. Wall thickness or gauge No.

TYPE OF SCREEN OR PERFORATION MATERIAL:

1 Steel 3 Stainless steel

5 Fiberglass

7 PVC

10 Asbestos-cement

2 Brass 4 Galvanized steel

6 Concrete tile

8 RMP (SR)

11 Other (specify)

9 ABS

12 None used (open hole)

SCREEN OR PERFORATION OPENINGS ARE:

1 Continuous slot 3 Mill slot

5 Gauzed wrapped

8 Saw cut

11 None (open hole)

6 Wire wrapped

9 Drilled holes

7 Torch cut

10 Other (specify)

SCREEN-PERFORATED INTERVALS: From... 250 ft. to 270 ft., From... 290 ft. to 295 ft.

From... ft. to ft., From... ft. to ft.

GRAVEL PACK INTERVALS: From... 20 ft. to 330 ft., From... ft. to ft.

From... ft. to ft., From... ft. to ft.

6 GROUT MATERIAL: 1 Neat cement 2 Cement grout 3 Bentonite 4 Other

Grout Intervals: From... 0 ft. to 20 ft., From... ft. to ft., From... ft. to ft.

What is the nearest source of possible contamination: 10 Livestock pens 14 Abandoned water well

1 Septic tank 4 Lateral lines

11 Fuel storage

15 Oil well/Gas well

2 Sewer lines 5 Cess pool

12 Fertilizer storage

16 Other (specify below)

3 Watertight sewer lines 6 Seepage pit

13 Insecticide storage

Dog Run

Direction from well? **East**How many feet? **35**

FROM TO LITHOLOGIC LOG FROM TO PLUGGING INTERVALS

0	45	Topsoil, clay & little fine sand	236	237	Fine Sand
45	105	Clay & little lime	237	240	Lime & Clay
105	135	Clay & sand	240	243	Fine Sand
135	144	Sand	243	251	Clay & little lime
144	150	Clay	251	255	Fine Sand
150	160	Clay & little sand	255	267	Sand & Clay
160	165	Sand	267	270	Clay
165	178	Sand & little clay	270	285	Clay & little lime
178	180	Clay	285	292	Sand
180	195	Clay & little fine sand	292	310	Clay & little lime
195	210	Clay & little lime	310	315	Clay (tight)
210	216	Clay & little fine sand	315	330	Clay turn to shale
216	229	Clay & little lime			
229	231	Fine sand			
231	236	Clay & little lime			

7 CONTRACTOR'S OR LANDOWNER'S CERTIFICATION: This water well was (1) constructed, (2) reconstructed, or (3) plugged under my jurisdiction and was completed on (mo/day/year) ... 5-31-96 and this record is true to the best of my knowledge and belief. Kansas

Water Well Contractor's License No. ... 223 This Water Well Record was completed on (mo/day/yr) ... 6-13-96

under the business name of **Dunham Drilling Company** by (signature) **Karen Dunham**

INSTRUCTIONS: Use typewriter or ball point pen. PLEASE PRESS FIRMLY and PRINT clearly. Please fill in blanks, underline or circle the correct answers. Send top three copies to Kansas Department of Health and Environment, Bureau of Water, Topeka, Kansas 66620-0001. Telephone: 913-296-5545. Send one to WATER WELL OWNER and retain one for your records.