

WATER WELL RECORD Form WWC-5 KSA 82a-1212

1 LOCATION OF WATER WELL:

Fraction

NW 1/4

NW 1/4

NW 1/4

Section Number

8

Township Number

T

28 S

Range Number

R 29

EW

County: Gray

Distance and direction from nearest town or city street address of well if located within city?

Approx. 4 1/2 west and 2 1/2 north of Montezuma 67867

2 WATER WELL OWNER: Charles Wiley


RR#, St. Address, Box #: Rt. #2, Box 62

Board of Agriculture, Division of Water Resources

City, State, ZIP Code: Montezuma, Kansas 67867

Application Number:

3 LOCATE WELL'S LOCATION WITH AN "X" IN SECTION BOX:

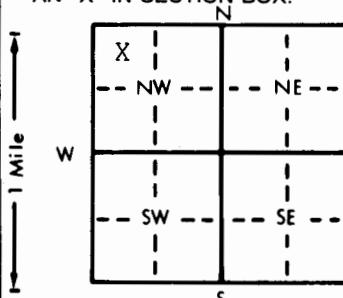

4 DEPTH OF COMPLETED WELL 430 ft. ELEVATION:

Depth(s) Groundwater Encountered 1..... ft. 2..... ft. 3..... ft.

WELL'S STATIC WATER LEVEL 149 ft. below land surface measured on mo/day/yr 11/15/82

Pump test data: Well water was ft. after hours pumping gpm

Est. Yield 18 gpm: Well water was ft. after hours pumping gpm

Bore Hole Diameter 9 7/8 in. to ft. and in. to ft.

WELL WATER TO BE USED AS: 5 Public water supply 8 Air conditioning 11 Injection well

1 Domestic 3 Feedlot 6 Oil field water supply 9 Dewatering 12 Other (Specify below)

2 Irrigation 4 Industrial 7 Lawn and garden only 10 Observation well

Was a chemical/bacteriological sample submitted to Department? Yes No X If yes, mo/day/yr sample was submitted

Water Well Disinfected? Yes X No

5 TYPE OF BLANK CASING USED:

5 Wrought iron

8 Concrete tile

CASING JOINTS: Glued Clamped

1 Steel 3 RMP (SR)

6 Asbestos-Cement

9 Other (specify below)

Welded X

2 PVC 4 ABS

7 Fiberglass

Threaded

Blank casing diameter 5 in. to 430 ft., Dia in. to ft., Dia in. to ft.

Casing height above land surface 12 in., weight 2,9 lbs./ft. Wall thickness or gauge No. 265 ft.

TYPE OF SCREEN OR PERFORATION MATERIAL:

7 PVC

10 Asbestos-cement

1 Steel 3 Stainless steel

5 Fiberglass

8 RMP (SR)

11 Other (specify)

2 Brass 4 Galvanized steel

6 Concrete tile

9 ABS

12 None used (open hole)

SCREEN OR PERFORATION OPENINGS ARE:

5 Gauzed wrapped

8 Saw cut

11 None (open hole)

1 Continuous slot 3 Mill slot

6 Wire wrapped

9 Drilled holes

2 Louvered shutter 4 Key punched

7 Torch cut

10 Other (specify)

SCREEN-PERFORATED INTERVALS: From 195-205 ft. to 330-340 ft., From 380-430 ft. to ft.

From ft. to ft., From ft. to ft., From ft. to ft.

GRAVEL PACK INTERVALS: From 10 ft. to 430 ft., From ft. to ft., From ft. to ft.

From ft. to ft., From ft. to ft., From ft. to ft.

6 GROUT MATERIAL: 1 Neat cement

2 Cement grout

3 Bentonite

4 Other

Grout Intervals: From 0 ft. to 10 ft., From ft. to ft., From ft. to ft.

What is the nearest source of possible contamination: Non observed

10 Livestock pens

14 Abandoned water well

1 Septic tank 4 Lateral lines

7 Pit privy

11 Fuel storage

15 Oil well/Gas well

2 Sewer lines 5 Cess pool

8 Sewage lagoon

12 Fertilizer storage

16 Other (specify below)

3 Watertight sewer lines 6 Seepage pit

9 Feedyard

13 Insecticide storage

Direction from well?

How many feet?

FROM TO LITHOLOGIC LOG FROM TO LITHOLOGIC LOG

See attached log

7 CONTRACTOR'S OR LANDOWNER'S CERTIFICATION: This water well was (1) constructed, (2) reconstructed, or (3) plugged under my jurisdiction and was completed on (mo/day/year) November 12, 1982 and this record is true to the best of my knowledge and belief. Kansas

Water Well Contractor's License No. 145 This Water Well Record was completed on (mo/day/yr) January 21, 1983 under the business name of Henkle Drilling & Supply Co., Inc. by (signature) *Bruce J. Reichmuth*

INSTRUCTIONS: Use typewriter or ball point pen, PLEASE PRESS FIRMLY and PRINT clearly. Please fill in blanks, underline or circle the correct answers. Send top three copies to Kansas Department of Health and Environment, Division of Environment, Environmental Geology Section, Topeka, KS 66620. Send one to WATER WELL OWNER and retain one for your records.

DRILLERS TEST LOG

CUSTOMERS NAME Charles Wiley DATE 11-9-82
 STREET ADDRESS Rt. #2, Box 62 TEST # 1 E. LOG Yes
 CITY & STATE Montezuma, Kansas 67867 DRILLER Mai
 COUNTY Gray QUARTER NW SECTION 8 TOWNSHIP 28 RANGE 29

5" PVC	PERF	PLAIN
430 - 380	50'	
380 - 340		40'
340 - 330	10'	
330 - 205		125'
205 - 195	10	
195 - 0 + 1		195' + 1
TOTAL	70'	360' + 1