

1 LOCATION OF WATER WELL:		Fraction County: <b>Geary</b>	NE $\frac{1}{4}$ NE $\frac{1}{4}$ SW $\frac{1}{4}$	Section Number 24	Township Number T 28 S	Range Number R 29 EW
---------------------------	--	----------------------------------	--	----------------------	---------------------------	-------------------------

Distance and direction from nearest town or city street address of well if located within city?

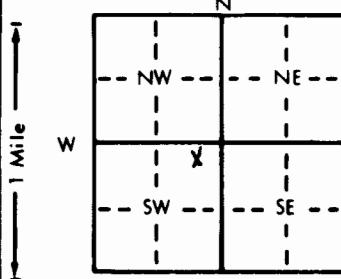
2 WATER WELL OWNER: **KDHE Code #5**RR#, St. Address, Box #: **01035352**

Board of Agriculture, Division of Water Resources

City, State, ZIP Code: **01035054**

Application Number:

## 3 LOCATE WELL'S LOCATION WITH AN "X" IN SECTION BOX:

4 DEPTH OF COMPLETED WELL: **145** ft. ELEVATION: .....

Depth(s) Groundwater Encountered 1 ft. 2 ..... ft. 3 ..... ft.

WELL'S STATIC WATER LEVEL: **125** ft. below land surface measured on mo/day/yr .....

Pump test data: Well water was ..... ft. after ..... hours pumping ..... gpm

Est. Yield ..... gpm: Well water was ..... ft. after ..... hours pumping ..... gpm

Bore Hole Diameter: **8** in. to **145** ft., and ..... in. to ..... ft.

WELL WATER TO BE USED AS: 5 Public water supply 8 Air conditioning 11 Injection well

1 Domestic 3 Feedlot 6 Oil field water supply 9 Dewatering 12 Other (Specify below)

2 Irrigation 4 Industrial 7 Lawn and garden only **10 Monitoring well**

Was a chemical/bacteriological sample submitted to Department? Yes ..... No ..... X; If yes, mo/day/yr sample was submitted

Water Well Disinfected? Yes No X

## 5 TYPE OF BLANK CASING USED:

1 Steel 3 RMP (SR)  
2 PVC 4 ABS

5 Wrought iron

6 Asbestos-Cement  
7 Fiberglass

8 Concrete tile

9 Other (specify below)

CASING JOINTS: Glued .....

Clamped .....

Welded .....

Threaded .....

Blank casing diameter: **4** in. to **115** ft., Dia ..... in. to ..... ft., Dia ..... in. to ..... ft.Casing height above land surface: **0** in., weight ..... lbs./ft. Wall thickness or gauge No. ....

## TYPE OF SCREEN OR PERFORATION MATERIAL:

1 Steel 3 Stainless steel  
2 Brass 4 Galvanized steel

5 Fiberglass  
6 Concrete tile8 RMP (SR)  
9 ABS

5 Gauzed wrapped

6 Wire wrapped

7 Torch cut

7 PVC

10 Asbestos-cement

11 Other (specify) .....

12 None used (open hole)

11 None (open hole)

8 Saw cut

9 Drilled holes

10 Other (specify) .....

## SCREEN OR PERFORATION OPENINGS ARE:

1 Continuous slot 3 Mill slot  
2 Louvered shutter 4 Key punched

5 Gauzed wrapped

6 Wire wrapped

7 Torch cut

SCREEN-PERFORATED INTERVALS: From: **115** ft. to **145** ft., From ..... ft. to ..... ft.

From ..... ft. to ..... ft., From ..... ft. to ..... ft.

GRAVEL PACK INTERVALS: From: **113** ft. to **145** ft., From ..... ft. to ..... ft.

From ..... ft. to ..... ft., From ..... ft. to ..... ft.

## 6 GROUT MATERIAL: 1 Neat cement 2 Cement grout 3 Bentonite 4 Other .....

Grout Intervals: From: **113** ft. to **0** ft., From ..... ft. to ..... ft., From ..... ft. to ..... ft.

What is the nearest source of possible contamination:

1 Septic tank 4 Lateral lines 7 Pit privy  
2 Sewer lines 5 Cess pool 8 Sewage lagoon  
3 Watertight sewer lines 6 Seepage pit 9 Feedyard

10 Livestock pens

11 Fuel storage

12 Fertilizer storage

13 Insecticide storage

14 Abandoned water well

15 Oil well/Gas well

16 Other (specify below)

Direction from well?

FROM	TO	LITHOLOGIC LOG	FROM	TO	PLUGGING INTERVALS
0	10	Overburden			
10	40	Sandy Clay			
40	60	Sandy Clay (Black Stripes)			
60	70	Sandy Clay			
70	80	Gravel			
80	90	Sandy Clay Cemented Sand (Black)			
90	100	Strips of Sand: Cemented Sand			
100	110	Cemented Sand: Sandy Clay			
110	120	Cemented Sand Small Stripes			
120	130	Small Sand Strips Sand Clay			
130	140	Sandy Clay			
140	144	Sand Small pebbles			
144	145	Clay.			

7 CONTRACTOR'S OR LANDOWNER'S CERTIFICATION: This water well was (1) constructed, (2) reconstructed, or (3) plugged under my jurisdiction and was completed on (mo/day/year) **11/19/91** and this record is true to the best of my knowledge and belief. KansasWater Well Contractor's License No. **K3 300** This Water Well Record was completed on (mo/day/y) **11/19/91** under the business name of **Hutton Drilling Co.** by (signature) 