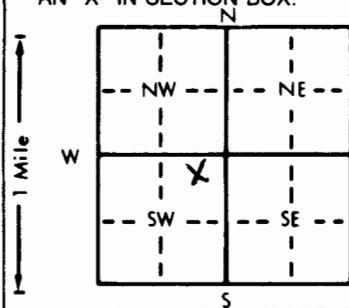


1 LOCATION OF WATER WELL:	Fraction County: <u>Beaumont</u>	NE $\frac{1}{4}$ NE $\frac{1}{4}$ SW $\frac{1}{4}$	Section Number T 28 S	Township Number R 29 E	Range Number
---------------------------	-------------------------------------	--	--------------------------	---------------------------	--------------

Distance and direction from nearest town or city street address of well if located within city?

2 WATER WELL OWNER: KOHE CODE #15RR#, St. Address, Box #: 01033332
City, State, ZIP Code: 01033054Board of Agriculture, Division of Water Resources
Application Number:3 LOCATE WELL'S LOCATION WITH AN "X" IN SECTION BOX: NE4 DEPTH OF COMPLETED WELL: 145 ft. ELEVATION:

Depth(s) Groundwater Encountered 1. ft. 2. ft. 3. ft.

WELL'S STATIC WATER LEVEL: 125 ft. below land surface measured on mo/day/yr

Pump test data: Well water was ft. after hours pumping gpm

Est. Yield: 1 gpm: Well water was ft. after hours pumping gpmBore Hole Diameter: 7.75 in. to 145 ft. and in. to ft.

WELL WATER TO BE USED AS: 5 Public water supply 8 Air conditioning 11 Injection well

1 Domestic 3 Feedlot 6 Oil field water supply 9 Dewatering 12 Other (Specify below)

2 Irrigation 4 Industrial 7 Lawn and garden only 10 Monitoring well

Was a chemical/bacteriological sample submitted to Department? Yes No If yes, mo/day/yr sample was submittedWater Well Disinfected? Yes No

5 TYPE OF BLANK CASING USED:

1 Steel 3 RMP (SR)
2 PVC 4 ABS

5 Wrought iron

8 Concrete tile

CASING JOINTS: Glued Clamped

6 Asbestos-Cement

9 Other (specify below)

Welded

7 Fiberglass

Threaded Blank casing diameter: 8 in. to 115 ft. Dia. in. to ft. Dia. in. to ft.Casing height above land surface: 0 in., weight lbs./ft. Wall thickness or gauge No.

TYPE OF SCREEN OR PERFORATION MATERIAL:

1 Steel 3 Stainless steel
2 Brass 4 Galvanized steel

5 Fiberglass

8 RMP (SR)

10 Asbestos-cement

6 Concrete tile

9 ABS

11 Other (specify)

12 None used (open hole)

5 Gauzed wrapped

7 PVC

8 Saw cut

11 None (open hole)

6 Wire wrapped

9 Drilled holes

7 Torch cut

10 Other (specify)

SCREEN OR PERFORATION OPENINGS ARE: From: 115 ft. to 145 ft., From: ft. to ft., From: ft. to ft.

From: ft. to ft., From: ft. to ft., From: ft. to ft., From: ft. to ft.

SCREEN-PERFORATED INTERVALS: From: 113 ft. to 145 ft., From: ft. to ft., From: ft. to ft.

From: ft. to ft., From: ft. to ft., From: ft. to ft., From: ft. to ft.

GRAVEL PACK INTERVALS: From: 113 ft. to 145 ft., From: ft. to ft., From: ft. to ft.

From: ft. to ft., From: ft. to ft., From: ft. to ft., From: ft. to ft.

6 GROUT MATERIAL: 1 Neat cement 2 Cement grout 3 Bentonite 4 Other

Grout Intervals: From: 113 ft. to 0 ft., From: ft. to ft., From: ft. to ft., From: ft. to ft.

What is the nearest source of possible contamination:

1 Septic tank 4 Lateral lines
2 Sewer lines 5 Cess pool
3 Watertight sewer lines 6 Seepage pit

10 Livestock pens

14 Abandoned water well

11 Fuel storage

15 Oil well/Gas well

12 Fertilizer storage

16 Other (specify below)

13 Insecticide storage

How many feet?

FROM TO LITHOLOGIC LOG FROM TO PLUGGING INTERVALS

0	30	Sandy Clay Br.-tan			
30	60	Sandy Clay Tan			
60	70	Sandy Clay Tan-Br. w/ Colicines			
70	80	Sandy Clay Cemented Sand			
80	90	Sand Cemented Shells w/ Gravel			
90	110	Sand Clay			
110	120	Sandy Clay w/ Sand Shells			
120	145	Sandy Clay w/ Sand Shells			

7 CONTRACTOR'S OR LANDOWNER'S CERTIFICATION: This water well was (1) constructed, (2) reconstructed, or (3) plugged under my jurisdiction and was completed on (mo/day/year) 9-10-91 and this record is true to the best of my knowledge and belief. KansasWater Well Contractor's License No. KS-300, This Water Well Record was completed on (mo/day/yr) 9-24-91 by (signature) Fulton Drilling Co.