


1 LOCATION OF WATER WELL:	Fraction	Section Number	Township Number	Range Number
County: Gray	NE ¼ SW ¼ SW ¼	32	T 28 S	R 29 E

Distance and direction from nearest town or city street address of well if located within city?

Approx. 2 1/2 miles south & 4 3/4 miles west of Montezuma, KS

2	WATER WELL OWNER:	Vernon Giesbrecht	
	RR#, St. Address, Box # :		Board of Agriculture, Division of Water Resources
	City, State, ZIP Code :	Cimarron, KS 67835	Application Number: 14 447

3 LOCATE WELL'S LOCATION WITH AN "X" IN SECTION BOX: 4 DEPTH OF COMPLETED WELL..... 283' ft. ELEVATION:

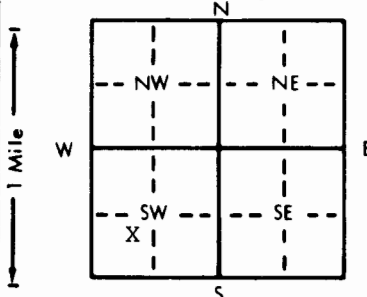

4 DEPTH OF COMPLETED WELL..... 283' ft. ELEVATION:

Depth(s) Groundwater Encountered 1. ft. 2. ft. 3. ft.
WELL'S STATIC WATER LEVEL . . . 121' . . . ft. below land surface measured on mo/day/yr . . . 5/1/89

	Pump test data:	Well water was	ft. after	hours pumping	gpm
Est. Yield	1400	gpm:	Well water was	268'	ft. after	4	hours pumping	1447
								gpm

Bore Hole Diameter . . . 24" . . . in. to . . . 283' . . . ft., and in. to ft.

WELL WATER TO BE USED AS:		5 Public water supply	8 Air conditioning	11 Injection well
1 Domestic	3 Feedlot	6 Oil field water supply	9 Dewatering	12 Other (Specify below)

2 Irrigation 4 Industrial 7 Lawn and garden only 10 Monitoring well
Was a chemical/bacteriological sample submitted to Department? Yes No ☒ If yes, mo/day/yr sample was sub

Was a chemical/bacteriological sample submitted to Department? Yes.....No....., if yes, the day/ sample was submitted

Water Well Disinfected? Yes No X

5) TYPE OF BLANK CASING USED:		5 Wrought iron	8 Concrete tile	CASING JOINTS: Glued Clamped
<u>1 Steel</u>	3 RMP (SR)	6 Asbestos-Cement	9 Other (specify below)	Welded X

2 PVC	4 ABS	7 Fiberglass	Threaded.....
Blank casing diameter	16 in. to	283' ft Dia	in. to	ft Dia

Casing height above land surface..... 12..... in., weight..... 42.05..... lbs./ft. Wall thickness or gauge No. 250W

TYPE OF SCREEN OR PERFORATION MATERIAL:

<u>1 Steel</u>	3 Stainless steel	5 Fiberglass	7 PVC	10 Asbestos-cement
			8 RMP (SR)	11 Other (specify)

2 Brass	4 Galvanized steel	6 Concrete tile	9 ABS	12 None used (open hole)
SCREEN OR PERFORATION OPENINGS ARE:		5 Gauzed wrapped	8 Saw cut	11 None (open hole)

<u>1 Continuous slot</u>	3 Mill slot	5 Glazed wrapped	8 Saw cut	11 None (open hole)
		6 Wire wrapped	9 Drilled holes	

2 Louvered shutter 4 Key punched 7 Torch cut 10 Other (specify)

SCREEN-PERFORATED INTERVALS: From 243' ft. to 283' ft., From 147' ft. to 167' ft.

	From	ft.	to	ft.	From	ft.	to	ft.	
GRAVEL PACK INTERVALS:	20'	ft.	to	283'	ft.	From	ft.	to	ft.

GRAVEL PASS INTERVALS:		From	ft. to	ft., From	ft. to	ft.
		From	ft. to	ft., From	ft. to	ft.

6) GROUT MATERIAL: 1 Neat cement 2 Cement grout 3 Bentonite 4 Other

Grout Intervals: From 0 ft. to 20 ft., From ft. to ft., From ft. to ft.

What is the nearest source of possible contamination:

1. Sptic tank	4. Lateral lines	7. Pit privy	10. Livestock pens	14. Abandoned water well
2. Septic system	5. Leaking water main	8. Leaking sewer	11. Fuel storage	15. Oil well/Gas well

1 Septic tank	4 Lateral lines	7 Pit privy	11 Fuel storage	15 Oil well/Gas well
2 Sewer lines	5 Cess pool	8 Sewage lagoon	12 Fertilizer storage	16 Other (specify below)

3 Watertight sewer lines 6 Seepage pit 9 Feedyard 13 Insecticide storage None observed

Direction from well? How many feet?

FROM	TO	LITHOLOGIC LOG	FROM	TO	PLUGGING INTERVALS

		See log attached			
--	--	------------------	--	--	--

[illegible]

[illegible][illegible]

[illegible]

CONTRACTOR'S OR LANDOWNER'S CERTIFICATION: This water well was (1) constructed, (2) reconstructed, or (3) plugged under my jurisdiction and was completed on (mo/day/year) . . . 4/27/89 and this record is true to the best of my knowledge and belief. Kansas

Water Well Contractor's License No. 145 This Water Well Record was completed on (mo/day/yr) 6/14/89
under the business name of Henkle Drilling & Supply Co., Inc. by (signature) Bruce J. Henkle

INSTRUCTIONS: Use typewriter or ball point pen. PLEASE PRESS FIRMLY and PRINT clearly. Please fill in blanks, underline or circle the correct answers. Send top three copies to Kansas Department of Health and Environment, Bureau of Water Protection, Topeka, Kansas 66620-7320. Telephone: 913-296-5514. Send one to WATER WELL OWNER and retain one for your records.


DRILLERS TEST LOG

CUSTOMER'S NAME: Vernon Giesbrecht DATE: 3-9-89
STREET ADDRESS: _____ TEST # 2 E. LOG Yes
CITY & STATE: Cimarron, KS 67835 DRILLER Wildeman
COUNTY Gray QUARTER SW SECTION 32 TOWNSHIP 28 RANGE 29
LOCATION 2300' Southwest of old well

[illegible]

GARDEN CITY, KS 67846
3795 West Jones Ave.

HENKLE DRILLING & SUPPLY CO., INC.

316-277-2389

IRRIGATION HEADQUARTERS

TEST HOLES * * * * * IRRIGATION & INDUSTRIAL WELLS * * * * * STOCK WELLS