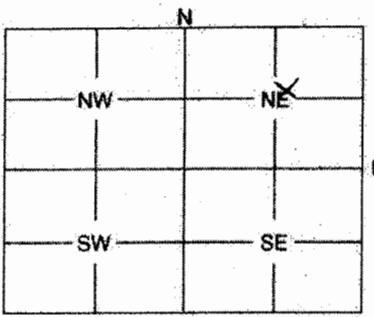


1	LOCATION OF WATER WELL: County: Gray	Fraction NE $\frac{1}{4}$ NE $\frac{1}{4}$ SW $\frac{1}{4}$	Section Number 24	Township Number 28	Range Number 29
Distance and direction from nearest town or city street address of well if located within city? Montezuma 400 W. Texcoco					
2	WATER WELL OWNER: Grain Growers Assoc RR #, St. Address, Box #: c/o Dodge City Cooperative Exchange City, State, ZIP Code: Dodge City, Ks 67801		Board of Agriculture, Division of Water Resources Application Number:		
3	MARK WELL'S LOCATION WITH AN "X" IN SECTION BOX: 	4 DEPTH OF WELL 144 ft.	WELL'S STATIC WATER LEVEL 126.9 ft.		
		WELL WAS USED AS: 1 Domestic 5 Public Water Supply 9 Dewatering 2 Irrigation 6 Oil Field Water Supply 10 Monitoring Well 3 Feedlot 7 Domestic (Lawn & Garden) 11 Injection Well 4 Industrial 8 Air Conditioning 12 Other			
		Was a chemical / bacteriological sample submitted to Department? Yes No X If yes, mo/day/yr sample was submitted			
		Water Well Disinfected: Yes No X			
5	TYPE OF BLANK CASING USED: 1 Steel 3 RMP (SR) 5 Wrought 7 Fiberglass 9 Other (Specify below) 2 PVC 4 ABS 6 Asbestos-Cement 8 Concrete Tile				
	Blank casing diameter in. Was casing pulled? Yes No X If yes, how much				
6	GROUT PLUG MATERIAL: 1 Neat cement 2 Cement grout 3 Bentonite 4 Other Surface silts and clays..... Grout Plug Intervals: <i>Chlor. Sand</i> From 144 ft. to 115 ft., From 115 ft. to 3 ft., From 3 to 0 ft.				
	What is the nearest source of possible contamination: 1 Septic tank 6 Seepage pit 11 Fuel storage 16 Other (specify below) 2 Sewer lines 7 Pit privy 12 Fertilizer storage <i>Chlor. S.t.e.</i> 3 Watertight sewer lines 8 Sewage lagoon 13 Insecticide storage 4 Lateral lines 9 Feedyard 14 Abandoned water well 5 Cess pool 10 Livestock pens 15 Oil well/Gas well				
	Direction from well? How many feet?				
	FROM	TO	PLUGGING MATERIALS		
144	115	Chlorinated Sand			
115	3	Bentonite			
3	0	Surface silts/clays			
7	CONTRACTOR'S OF LANDOWNER'S CERTIFICATION: This water well was plugged under my jurisdiction and was completed on (mo/day/year) 10/05/04 and this record is true to the best of my knowledge and belief. Kansas Water Well Contractor's License No. 585 This Water Well Record was completed on (mo/day/year) 12/07/04 under the business name of Associated Environmental, Inc.				
	by (signature) Darin Duncan <i>D. Duncan</i>				
INSTRUCTIONS: Use typewriter or ball point pen. Please press firmly and print clearly. Please fill in blanks, underline or circle the correct answers. Send top three copies to Kansas Department of Health and Environment, Bureau of Water, Geology Section, 1000 SW Jackson St., Ste. 420, Topeka, Kansas 66612-1367. Telephone: 785/296-5522. Send one to Water Well Owner and retain one for your records.					