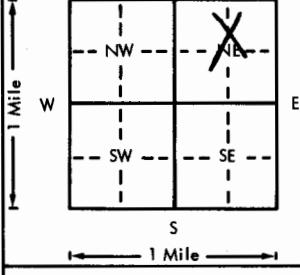


USE TYPEWRITER OR BALL
POINT PEN-PRESS FIRMLY,
PRINT CLEARLY.

WATER WELL RECORD
KSA 82a-1201-1215

Kansas Department of Health and
Environment-Division of Environment
(Water well Contractors)
Topeka, Kansas 66620

1. Location of well: GRAY	County	Fraction SW NE NW 1/4 SW 1/4 NE 1/4	Section number 3	Township number T 28	Range number S R 29 NW				
2. Distance and direction from nearest town or city: Montezuma, Ks. 67867 Street address of well location if in city:	3. Owner of well: Denton Unruh R.R. or street: Montezuma, Ks. 67867 City, state, zip code:								
4. Locate with "X" in section below: 	Sketch map:		6. Bore hole dia. 26 in. Completion date 3-22-76 Well depth 197 ft.						
		7. <input type="checkbox"/> Cable tool <input type="checkbox"/> Rotary <input type="checkbox"/> Driven <input type="checkbox"/> Dug <input type="checkbox"/> Hollow rod <input type="checkbox"/> Jetted <input type="checkbox"/> Bored <input checked="" type="checkbox"/> Reverse rotary							
		8. Use: <input type="checkbox"/> Domestic <input type="checkbox"/> Public supply <input type="checkbox"/> Industry <input checked="" type="checkbox"/> Irrigation <input type="checkbox"/> Air conditioning <input type="checkbox"/> Stock <input type="checkbox"/> Lawn <input type="checkbox"/> Oil field water <input type="checkbox"/> Other							
		9. Casing: Material <input type="checkbox"/> steel <input type="checkbox"/> Threaded <input type="checkbox"/> Welded <input checked="" type="checkbox"/> Surface <input type="checkbox"/> 12 in. RMP <input type="checkbox"/> PVC <input type="checkbox"/> Weight 36.87 lbs./ft. Dia. <input type="checkbox"/> in. to <input checked="" type="checkbox"/> 198 depth <input type="checkbox"/> Wall Thickness: inches or Dia. <input type="checkbox"/> in. to <input type="checkbox"/> ft. depth <input type="checkbox"/> gauge No. <input checked="" type="checkbox"/> 250							
5. Type and color of material		From	To	10. Screen: Manufacturer's name: JOHNSON DIVISION Galv. <input type="checkbox"/> Dia. <input type="checkbox"/> 16" Type <input type="checkbox"/> 100 <input type="checkbox"/> Length <input type="checkbox"/> 20' Slot/gauze <input type="checkbox"/> 100 <input type="checkbox"/> Length <input type="checkbox"/> 20' Set between <input type="checkbox"/> 170 <input type="checkbox"/> ft. and <input type="checkbox"/> 190 <input type="checkbox"/> ft. Perf. <input type="checkbox"/> 132 <input type="checkbox"/> 170 <input type="checkbox"/> ft. and <input type="checkbox"/> 190-197 <input type="checkbox"/> ft. Gravel pack? <input type="checkbox"/> yes <input type="checkbox"/> Size range of material <input type="checkbox"/> 12 <input type="checkbox"/> 18 11. Static water level: <input type="checkbox"/> 3-17-76 yr. <input type="checkbox"/> ft. below land surface Date <input type="checkbox"/>					
		12. Pumping level below land surfaces: <input type="checkbox"/> 1425 <input type="checkbox"/> ft. after <input type="checkbox"/> hrs. pumping <input type="checkbox"/> g.p.m. <input type="checkbox"/> ft. after <input type="checkbox"/> hrs. pumping <input type="checkbox"/> g.p.m. Estimated maximum yield <input type="checkbox"/> 1425 <input type="checkbox"/> g.p.m.							
		13. Water sample submitted: <input type="checkbox"/> mo./day/yr. Yes <input checked="" type="checkbox"/> No <input type="checkbox"/> Date <input type="checkbox"/>							
		14. Well head completion: <input type="checkbox"/> Pitless adapter <input type="checkbox"/> 12 Inches above grade							
		15. Well grouted? <input checked="" type="checkbox"/> Yes With: <input type="checkbox"/> Neat cement <input type="checkbox"/> Bentonite <input type="checkbox"/> Concrete Depth: From <input type="checkbox"/> 0 <input type="checkbox"/> ft. to <input type="checkbox"/> 10 <input type="checkbox"/> ft.							
		16. Nearest source of possible contamination: <input type="checkbox"/> N/A ft. <input type="checkbox"/> Direction <input type="checkbox"/> Type <input type="checkbox"/> Well disinfected upon completion? <input type="checkbox"/> Yes <input checked="" type="checkbox"/> No							
		17. Pump: <input type="checkbox"/> Not installed Manufacturer's name: GOULDS US Pumps Model number <input type="checkbox"/> 10J10 <input type="checkbox"/> HP 60 <input type="checkbox"/> Volts <input type="checkbox"/> Length of drop pipe <input type="checkbox"/> 180 <input type="checkbox"/> ft. capacity <input type="checkbox"/> 1000 g.p.m. Type: <input type="checkbox"/> Submersible <input checked="" type="checkbox"/> Turbine <input type="checkbox"/> Jet <input type="checkbox"/> Reciprocating <input type="checkbox"/> Centrifugal <input type="checkbox"/> Other							
(Use a second sheet if needed)					20. Water well contractor's certification: This well was drilled under my jurisdiction and this report is true to the best of my knowledge and belief. Kinter Wilson Drilling 208 Business name: P.O. Box A Garden City, Ks. Address: <input type="checkbox"/> Signed: <input type="checkbox"/> Date: <input type="checkbox"/> Authorized representative: <input type="checkbox"/>				
18. Elevation:	19. Remarks:								
Topography: <input type="checkbox"/> Hill <input checked="" type="checkbox"/> Slope <input type="checkbox"/> Upland <input type="checkbox"/> Valley									

Forward the white, blue and pink copies to the Department of Health and Environment

Form WWC-5

The
Professionals **MINTER-WILSON DRILLING CO.** INCORPORATED

Irrigation
and Domestic
Water Systems
Complete Installation
and Repairing

Phone 276-8269 • P.O. Box 493 • GARDEN CITY, KANSAS 67846

DENTON UNRUH
Gray County
2-6-76

Location: NE^{1/4} 3-28-29 4 miles north of Montezuma,
1 1/2 west, 1/4 south on west side of road
Static Water Level - 120'

Test # 4

0	3	Top soil	Location
3	15	Brown sandy clay	
15	46	Fine sand	
46	58	Brown sandy clay	
58	72	Fine to med. sand	
72	98	Brown sandy clay-mixed white rock (Hard)	
98	110	Fine to med. sand & gravel (tight)	
110	132	Fine to med. sand & gravel- pull down	
132	144	Fine to med. sand & gravel	
144	150	Brown sandy clay	
150	156	Brown sandy clay-2' of gravel streak	
156	160	Fine to med. sand & gravel 15% clay (tight)	
160	168	Gray clay	
168	187	Fine to med. sand	
187	196	Brown and white clay mixed (Hard)	
196	216	Yellow clay mixed with rock - pull down	
216	217	Shale	

T.D. 199'

20' Screen