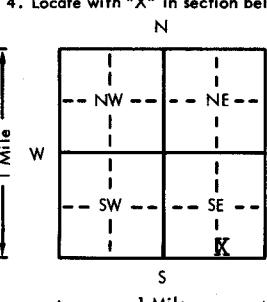


USE TYPEWRITER OR BALL
POINT PEN-PRESS FIRMLY,
PRINT CLEARLY.

WATER WELL RECORD
KSA 82g-1201-1215

Kansas Department of Health and
Environment-Division of Environment
(Water well Contractors)
Topeka, Kansas 66620

1. Location of well:	County Gray	Fraction SE 1/4 SE 1/4 SW 1/4	Section number 10	Township number T 28	Range number S R 29			
2. Distance and direction from nearest town or city: Street address of well location if in city:	3. Owner of well: R.R. or street: City, state, zip code: Mennonite Church Montezuma, Kansas 67867							
4. Locate with "X" in section below: 	Sketch map:	6. Bore hole dia <u>9 7/8</u> in. Completion date <u>7-15-76</u> Well depth <u>264</u> ft.						
						7. <input checked="" type="checkbox"/> Cable tool <input type="checkbox"/> Rotary <input type="checkbox"/> Driven <input type="checkbox"/> Dug <input type="checkbox"/> Hollow rod <input type="checkbox"/> Jetted <input type="checkbox"/> Bored <input type="checkbox"/> Reverse rotary		
						8. Use: <input checked="" type="checkbox"/> Domestic <input type="checkbox"/> Public supply <input type="checkbox"/> Industry <input type="checkbox"/> Irrigation <input type="checkbox"/> Air conditioning <input type="checkbox"/> Stock <input type="checkbox"/> Lawn <input type="checkbox"/> Oil field water <input type="checkbox"/> Other		
						9. Casing: Material <input checked="" type="checkbox"/> PVC <input type="checkbox"/> Height: Above or below Threaded <input type="checkbox"/> Welded <input type="checkbox"/> Surface _____ in. RMP <input type="checkbox"/> PVC <input type="checkbox"/> Weight _____ lbs./ft. Dia. <u>5</u> in. to <u>264</u> ft. depth Wall Thickness: inches or Dia. <u>5</u> in. to <u>264</u> ft. depth Gage No. <u>265</u>		
						10. Screen: Manufacturer's name <u>Wesco</u> Type <input checked="" type="checkbox"/> PVC Dia. <u>5"</u> Slot/gauze <u>.030</u> Length <u>55'</u> Set between <u>160</u> ft. and <u>261</u> ft. ft. and _____ ft. Gravel pack? <input checked="" type="checkbox"/> Yes Size range of material <u>3/16</u>		
						11. Static water level: mo./day/yr. <u>165</u> ft. below land surface Date <u>6/30/76</u>		
						12. Pumping level below land surfaces: ft. after _____ hrs. pumping _____ g.p.m. ft. after _____ hrs. pumping _____ g.p.m. Estimated maximum yield <u>11</u> g.p.m.		
						13. Water sample submitted: mo./day/yr. Yes <input checked="" type="checkbox"/> No _____ Date _____		
						14. Well head completion: <input checked="" type="checkbox"/> Pitless adapter _____ inches above grade		
						15. Well grouted? <input checked="" type="checkbox"/> Yes With: <input type="checkbox"/> Neat cement <input type="checkbox"/> Bentonite <input checked="" type="checkbox"/> Concrete Depth: From <u>4</u> ft. to <u>14</u> ft.		
						16. Nearest source of possible contamination: ft. <u>20</u> Direction <u>SW</u> Type <input checked="" type="checkbox"/> Well Well disinfected upon completion? <input checked="" type="checkbox"/> Yes <input type="checkbox"/> No _____		
						17. Pump: <input type="checkbox"/> Not installed Manufacturer's name <u>Aermotor</u> Model number <u>SD19</u> HP <u>2</u> Volt <u>220</u> Length of drop pipe <u>252</u> ft. capacity <u>20</u> g.p.m. Type: <u>XXX</u> Submersible <input type="checkbox"/> Turbine <input type="checkbox"/> Jet <input type="checkbox"/> Reciprocating <input type="checkbox"/> Centrifugal <input type="checkbox"/> Other		
						18. Elevation: Topography: <input type="checkbox"/> Hill <input type="checkbox"/> Slope <input checked="" type="checkbox"/> Upland <input type="checkbox"/> Valley	19. Remarks: <u>electric logged</u>	20. Water well contractor's certification: This well was drilled under my jurisdiction and this report is true to the best of my knowledge and belief. <u>Friesen Windmill</u> 252 Business name _____ License No. _____ Address <u>Meade Kansas 67864</u> Signed <u>J. Friesen</u> Date <u>8-4-76</u> Authorized representative
						(Use a second sheet if needed)		

Forward the white, blue and pink copies to the Department of Health and Environment

Form WWC-5