

WATER WELL RECORD

Form WWC-5

KSA 82a-1212


1 LOCATION OF WATER WELL:		Fraction 1/4 1/4 SE/4 1/4	Section Number 15	Township Number T 28 S	Range Number R 29W E/W
---------------------------	--	---	----------------------	-------------------------------------	-------------------------------------

Distance and direction from nearest town or city street address of well if located within city?

FROM MONTEZUMA: 7 N, 1.5 W, E N INTO LOC.

2 WATER WELL OWNER:		MINTER-WILSON DRILLING CO.		Orville Williams	Board of Agriculture, Division of Water Resources
RR#, St. Address, Box #:		P.O. BOX 669		Application Number:	
City, State, ZIP Code:		ULYSSES, KS 67880			

3 LOCATE WELL'S LOCATION WITH AN "X" IN SECTION BOX:		4 DEPTH OF COMPLETED WELL..... 230 ft. ELEVATION:	
--	--	---	--

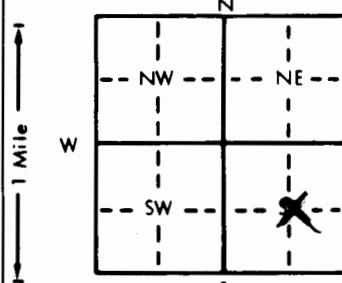

Depth(s) Groundwater Encountered 1..... ft. 2..... ft. 3..... ft.

WELL'S STATIC WATER LEVEL ft. below land surface measured on mo/day/yr 07-19-95

Pump test data: Well water was ft. after 1..... hours pumping gpm

Est. Yield gpm: Well water was ft. after hours pumping gpm

Bore Hole Diameter 11..... in. to 230..... ft., and in. to ft.

WELL WATER TO BE USED AS: 5 Public water supply 8 Air conditioning 11 Injection well

1 Domestic 3 Feedlot 6 Oil field water supply 9 Dewatering 12 Other (Specify below)

2 Irrigation 4 Industrial 7 Lawn and garden only 10 Monitoring well

Was a chemical/bacteriological sample submitted to Department? Yes..... No. If yes, mo/day/yr sample was submittedWater Well Disinfected? Yes No

5 TYPE OF BLANK CASING USED:		5 Wrought iron	8 Concrete tile	CASING JOINTS: Glued <input checked="" type="checkbox"/> Clamped
1 Steel	3 RMP (SR)	6 Asbestos-Cement	9 Other (specify below)	Welded
2 PVC	4 ABS	7 Fiberglass		Threaded

Blank casing diameter 6..... in. to 230..... ft., Dia in. to ft., Dia in. to ft.

Casing height above land surface 24..... in., weight 2.902..... lbs./ft. Wall thickness or gauge No. 280 SDR 21

TYPE OF SCREEN OR PERFORATION MATERIAL:

1 Steel	3 Stainless steel	5 Fiberglass	8 RMP (SR)	10 Asbestos-cement
2 Brass	4 Galvanized steel	6 Concrete tile	9 ABS	11 Other (specify)

SCREEN OR PERFORATION OPENINGS ARE:

1 Continuous slot	3 Mill slot	5 Gauzed wrapped	8 Saw cut	11 None (open hole)
2 Louvered shutter	4 Key punched	6 Wire wrapped	9 Drilled holes	
		7 Torch cut	10 Other (specify)	

SCREEN-PERFORATED INTERVALS: From 170..... ft. to 230..... ft., From ft. to ft.

From ft. to ft., From ft. to ft.

GRAVEL PACK INTERVALS: From 150..... ft. to 230..... ft., From ft. to ft.

From ft. to ft., From ft. to ft.

6 GROUT MATERIAL:	1 Neat cement	2 Cement grout	3 Bentonite	4 Other HOLE PLUG
-------------------	---------------	----------------	-------------	--------------------------------

Grout Intervals: From 0..... ft. to 16..... ft., From ft. to ft., From ft. to ft.


What is the nearest source of possible contamination:

1 Septic tank	4 Lateral lines	7 Pit privy	10 Livestock pens	14 Abandoned water well
2 Sewer lines	5 Cess pool	8 Sewage lagoon	11 Fuel storage	15 Oil well/Gas well
3 Watertight sewer lines	6 Seepage pit	9 Feedyard	12 Fertilizer storage	16 Other (specify below)

Direction from well?

FROM	TO	LITHOLOGIC LOG	FROM	TO	PLUGGING INTERVALS
0	10	CLAY			
10	22	SANDY CLAY			
22	35	SANDY CLAY & SAND			
35	74	SANDY CLAY			
74	82	CLAY			
82	97	SANDY CLAY			
97	122	SAND & GRAVEL			
122	138	SANDY CLAY			
138	143	CLAY			
143	203	SAND & GRAVEL			
203	210	SANDY CLAY			
210	228	GRVEL & CLAY STREAKS			
228	230	YELLOW CLAY			

7 CONTRACTOR'S OR LANDOWNER'S CERTIFICATION: This water well was (1) constructed, (2) reconstructed, or (3) plugged under my jurisdiction and was completed on (mo/day/year) 07-19-95 and this record is true to the best of my knowledge and belief. Kansas

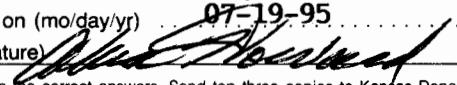Water Well Contractor's License No. KWCL-430 This Water Well Record was completed on (mo/day/yr) 07-19-95 under the business name of HOWARD DRLG.CO.BOX. 806 BEAVER, OK 73932 by (signature) 

INSTRUCTIONS: Use typewriter or ball point pen. PLEASE PRESS FIRMLY and PRINT clearly. Please fill in blanks, underline or circle the correct answers. Send top three copies to Kansas Department of Health and Environment, Bureau of Water, Topeka, Kansas 66620-0001. Telephone: 913-296-5545. Send one to WATER WELL OWNER and retain one for your records.

#21069