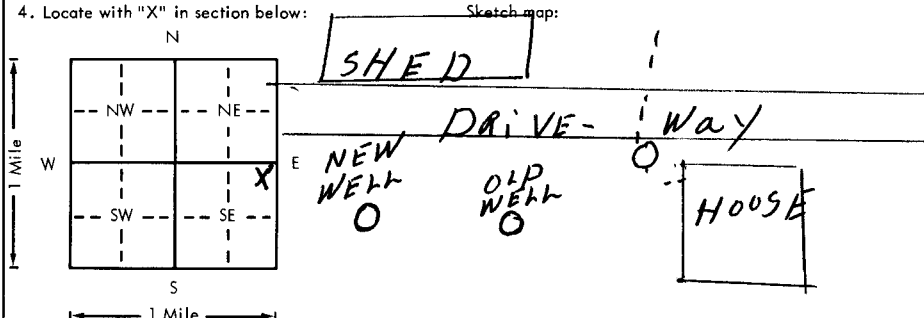


USE TYPEWRITER OR BALL  
POINT PEN-PRESS FIRMLY,  
PRINT CLEARLY.

WATER WELL RECORD  
KSA 82a-1201-1215

Kansas Department of Health and  
Environment-Division of Environment  
(Water well Contractors)  
Topeka, Kansas 66620

1. Location of well:	County <b>Gray,</b>	Fraction <b>NE 1/4 NE 1/4 SW 1/4</b>	Section number <b>20</b>	Township number <b>T 28 S</b>	Range number <b>R 29 E/W</b>
2. Distance and direction from nearest town or city: <b>3 miles West of Montezuma, Kansas on highway 56</b> Street address of well location if in city:			3. Owner of well: <b>Richard Jantz</b> R.R. or street: City, state, zip code: <b>Montezuma, Kansas 67867</b>		
4. Locate with "X" in section below: 			6. Bore hole dia. <b>8</b> in. Completion date <b>11-8-78</b> Well depth <b>197</b> ft.		
5. Type and color of material			7. <input type="checkbox"/> Cable tool <input checked="" type="checkbox"/> Rotary <input type="checkbox"/> Driven <input type="checkbox"/> Dug <input type="checkbox"/> Hollow rod <input type="checkbox"/> Jetted <input type="checkbox"/> Bored <input type="checkbox"/> Reverse rotary		
Top soil & clay			8. Use: <input checked="" type="checkbox"/> Domestic <input type="checkbox"/> Public supply <input type="checkbox"/> Industry <input type="checkbox"/> Irrigation <input type="checkbox"/> Air conditioning <input type="checkbox"/> Stock <input type="checkbox"/> Lawn <input type="checkbox"/> Oil field water <input type="checkbox"/> Other		
Clay			9. Casing: Material <b>RMP</b> Height: Above or below <b>xxxx</b> Threaded <input type="checkbox"/> Welded <input type="checkbox"/> Surface <b>12</b> in. RMP <b>xx</b> PVC <input type="checkbox"/> Weight <input type="checkbox"/> lbs./ft. Dia. <b>5</b> in. to <b>197</b> ft. depth Wall Thickness: inches or Dia. <input type="checkbox"/> in. to <input type="checkbox"/> ft. depth gage No. <b>250</b>		
Clay layers & fine sand			10. Screen: Manufacturer's name <b>Jess &amp; Lowell</b> Type <b>RMP</b> Dia. <b>5"</b> Slot/gauze <b>1/8"</b> Length <b>20 ft.</b> Set between <b>172</b> ft. and <b>192</b> ft. <input type="checkbox"/> ft. and <input type="checkbox"/> ft. Gravel pack? <b>yes</b> Size range of material <b>1"</b>		
Clay & fine to medium sand			11. Static water level: <input type="checkbox"/> mo./day/yr. <b>129</b> ft. below land surface Date <b>11-8-78</b>		
Fine to medium to clay			12. Pumping level below land surfaces: <b>133</b> ft. after <b>3</b> hrs. pumping <b>20</b> g.p.m. <input type="checkbox"/> ft. after <input type="checkbox"/> hrs. pumping <input type="checkbox"/> g.p.m. Estimated maximum yield <b>35</b> g.p.m.		
Clay & fine sand layers			13. Water sample submitted: <input type="checkbox"/> mo./day/yr. <input type="checkbox"/> Yes <input checked="" type="checkbox"/> No Date <input type="checkbox"/>		
Fine to coarse sand & clay (2 ft.)			14. Well head completion: <input checked="" type="checkbox"/> Pitless adapter <b>12</b> inches above grade		
Clay			15. Well grouted? <b>yes</b> With: <input checked="" type="checkbox"/> Neat cement <input type="checkbox"/> Bentonite <input type="checkbox"/> Concrete Depth: From <b>7</b> ft. to <b>20</b> ft.		
Clay & rock layers			16. Nearest source of possible contamination: ft. <b>70</b> Direction <b>East</b> Type <b>Sewer</b> Well disinfected upon completion? <input checked="" type="checkbox"/> Yes <input type="checkbox"/> No		
Clay & brown rock layers			17. Pump: <input checked="" type="checkbox"/> Not installed Manufacturer's name <input type="checkbox"/> Model number <input type="checkbox"/> HP <input type="checkbox"/> Volts <input type="checkbox"/> Length of drop pipe <input type="checkbox"/> ft. capacity <input type="checkbox"/> g.p.m. Type: <input type="checkbox"/> Submersible <input type="checkbox"/> Turbine <input type="checkbox"/> Jet <input type="checkbox"/> Reciprocating <input type="checkbox"/> Centrifugal <input type="checkbox"/> Other		
Brown rock layers & gray clay			20. Water well contractor's certification: This well was drilled under my jurisdiction and this report is true to the best of my knowledge and belief. <b>Joe's Well Service</b> <b>179</b> Business name License No. Address <b>Box 174 Cimarron, Ks.</b> Signed <b>Larry Erick</b> Date <b>11-16-78</b> Authorized representative		
Gray clay & sand stone					
(Use a second sheet if needed)					
18. Elevation:	19. Remarks:				
Topography: <input type="checkbox"/> Hill <input type="checkbox"/> Slope <input checked="" type="checkbox"/> Upland <input type="checkbox"/> Valley					

Forward the white, blue and pink copies to the Department of Health and Environment

Form WWC-5