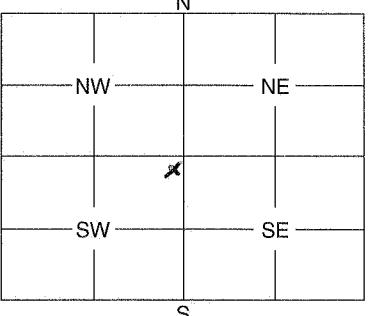


1	LOCATION OF WATER WELL: County: <i>Gray</i>	Fraction <i>NE 1/4 SE 1/4 SW 1/4</i>	Section Number <i>10</i>	Township Number <i>28</i>	Range Number <i>29</i>	Env <i>EW</i>
Distance and direction from nearest town or city street address of well if located within city? <i>Well located at 11506 A&A Rd.</i>						
2	WATER WELL OWNER: <i>Montezuma Mennonite Church</i>	Board of Agriculture, Division of Water Resources Application Number: <i>Montezuma, KS. 67867</i>				
3	RR #, St. Address, Box #: <i>11506 A&A Rd.</i> City, State, ZIP Code : <i>Montezuma, KS. 67867</i>					
4	MARK WELL'S LOCATION WITH AN "X" IN SECTION BOX: 	DEPTH OF WELL <i>160</i> ft.	WELL'S STATIC WATER LEVEL <i>Dry</i> ft.	WELL WAS USED AS:		
		<input checked="" type="checkbox"/> 1 Domestic 2 Irrigation 3 Feedlot 4 Industrial	<input type="checkbox"/> 5 Public Water Supply 6 Oil Field Water Supply 7 Domestic (Lawn & Garden) 8 Air Conditioning	<input type="checkbox"/> 9 Dewatering 10 Monitoring Well 11 Injection Well 12 Other		
5	TYPE OF BLANK CASING USED: Blank casing diameter Casing height above or below land surface	1 Steel 2 PVC	3 RMP (SR) 4 ABS	5 Wrought 6 Asbestos-Cement	7 Fiberglass 8 Concrete Tile	9 Other (Specify below) <i>Styrene</i>
6	GROUT PLUG MATERIAL: 1 Neat cement Grout Plug Intervals: From ft. to ft.	2 Cement grout	3 Bentonite	4 Other		
	What is the nearest source of possible contamination: 1 Septic tank 2 Sewer lines 3 Watertight sewer lines 4 Lateral lines 5 Cess pool	6 Seepage pit 7 Pit privy 8 Sewage lagoon 9 Feedyard 10 Livestock pens	11 Fuel storage 12 Fertilizer storage 13 Insecticide storage <input checked="" type="checkbox"/> 14 Abandoned water well 15 Oil well/Gas well	16 Other (specify below)		
	Direction from well? <i>east</i>	How many feet? <i>15</i>				
	FROM <i>3</i>	TO <i>23</i>	PLUGGING MATERIALS <i>Bentonite Chips</i>			
	<i>23</i>	<i>160</i>	<i>Compacted clays</i>			
7	CONTRACTOR'S OF LANDOWNER'S CERTIFICATION: This water well was plugged under my jurisdiction and was completed on (mo/day/year) <i>11/25/12</i> and this record is true to the best of my knowledge and belief. Kansas Water Well Contractor's License No. <i>533</i> This Water Well Record was completed on (mo/day/year) <i>10/14/13</i> under the business name of <i>Jantzen Water Well</i> by (signature) <i>J. Jantzen</i>					
INSTRUCTIONS: Use typewriter or ball point pen. Please press firmly and print clearly. Please fill in blanks, underline or circle the correct answers. Send top three copies to Kansas Department of Health and Environment, Bureau of Water, Geology Section, 1000 SW Jackson St., Ste. 420, Topeka, Kansas 66612-1367. Telephone: 785/296-5522. Send one to Water Well Owner and retain one for your records.						