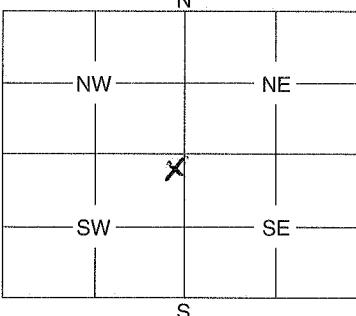


1	LOCATION OF WATER WELL: County: <u>Gray</u>	Fraction <u>NE 1/4 SE 1/4 SW 1/4</u>	Section Number <u>10</u>	Township Number <u>18</u>	Range Number <u>29</u>																								
Distance and direction from nearest town or city street address of well if located within city? <u>well location 11506 AA Rd.</u>																													
2	WATER WELL OWNER: <u>Montezuma Mennonite Church</u>	RR #, St. Address, Box #: <u>11506 AA Rd</u>	Board of Agriculture, Division of Water Resources Application Number: _____																										
3	City, State, ZIP Code : <u>Montezuma, KS. 67867</u>	4	DEPTH OF WELL <u>240</u> ft.	WELL'S STATIC WATER LEVEL <u>180</u> ft.																									
MARK WELL'S LOCATION WITH AN "X" IN SECTION BOX:		WELL WAS USED AS: <table> <tr><td><input checked="" type="checkbox"/> Domestic</td><td>5 Public Water Supply</td><td>9 Dewatering</td></tr> <tr><td>2 Irrigation</td><td>6 Oil Field Water Supply</td><td>10 Monitoring Well</td></tr> <tr><td>3 Feedlot</td><td>7 Domestic (Lawn & Garden)</td><td>11 Injection Well</td></tr> <tr><td>4 Industrial</td><td>8 Air Conditioning</td><td>12 Other</td></tr> </table>				<input checked="" type="checkbox"/> Domestic	5 Public Water Supply	9 Dewatering	2 Irrigation	6 Oil Field Water Supply	10 Monitoring Well	3 Feedlot	7 Domestic (Lawn & Garden)	11 Injection Well	4 Industrial	8 Air Conditioning	12 Other												
<input checked="" type="checkbox"/> Domestic	5 Public Water Supply	9 Dewatering																											
2 Irrigation	6 Oil Field Water Supply	10 Monitoring Well																											
3 Feedlot	7 Domestic (Lawn & Garden)	11 Injection Well																											
4 Industrial	8 Air Conditioning	12 Other																											
		Was a chemical / bacteriological sample submitted to Department? Yes No If yes, mo/day/yr sample was submitted Water Well Disinfected: Yes No																											
5	TYPE OF BLANK CASING USED:																												
1 Steel 2 PVC		3 RMP (SR) 4 ABS	5 Wrought 6 Asbestos-Cement	7 Fiberglass 8 Concrete Tile	9 Other (Specify below) <u>Shrrene</u>																								
Blank casing diameter <u>5</u> in.		Was casing pulled? <u>yes</u>		Yes <u>✓</u> No <u>✓</u>	If yes, how much																								
Casing height above or below land surface <u>18</u> in.																													
6	GROUT PLUG MATERIAL: 1 Neat cement 2 Cement grout 3 Bentonite 4 Other																												
Grout Plug Intervals: From <u>4</u> ft. to <u>24</u> ft.		From ft. to ft., From ft. to ft., From ft. to ft.																											
What is the nearest source of possible contamination:																													
1 Septic tank 2 Sewer lines 3 Watertight sewer lines 4 Lateral lines 5 Cess pool		6 Seepage pit 7 Pit privy 8 Sewage lagoon 9 Feedyard 10 Livestock pens		11 Fuel storage 12 Fertilizer storage 13 Insecticide storage <input checked="" type="checkbox"/> 14 Abandoned water well 15 Oil well/Gas well																									
16 Other (specify below)																													
Direction from well? <u>west</u>		How many feet? <u>25</u>																											
<table border="1"> <thead> <tr> <th>FROM</th> <th>TO</th> <th>PLUGGING MATERIALS</th> </tr> </thead> <tbody> <tr><td><u>4</u></td><td><u>24</u></td><td><u>Bentonite Chips</u></td></tr> <tr><td><u>24</u></td><td><u>180</u></td><td><u>Compacted clays</u></td></tr> <tr><td><u>180</u></td><td><u>240</u></td><td><u>Chlorinated Sand</u></td></tr> <tr><td> </td><td> </td><td> </td></tr> <tr><td> </td><td> </td><td> </td></tr> <tr><td> </td><td> </td><td> </td></tr> <tr><td> </td><td> </td><td> </td></tr> </tbody> </table>						FROM	TO	PLUGGING MATERIALS	<u>4</u>	<u>24</u>	<u>Bentonite Chips</u>	<u>24</u>	<u>180</u>	<u>Compacted clays</u>	<u>180</u>	<u>240</u>	<u>Chlorinated Sand</u>												
FROM	TO	PLUGGING MATERIALS																											
<u>4</u>	<u>24</u>	<u>Bentonite Chips</u>																											
<u>24</u>	<u>180</u>	<u>Compacted clays</u>																											
<u>180</u>	<u>240</u>	<u>Chlorinated Sand</u>																											
7	CONTRACTOR'S OF LANDOWNER'S CERTIFICATION: This water well was plugged under my jurisdiction and was completed on (mo/day/year) <u>11/25/12</u> and this record is true to the best of my knowledge and belief. Kansas Water Well Contractor's License No. <u>533</u> This Water Well Record was completed on (mo/day/year) <u>10/4/13</u> under the business name of <u>Jantzen Water Well</u> by (signature) <u>John Jantzen</u>																												
INSTRUCTIONS: Use typewriter or ball point pen. Please press firmly and print clearly. Please fill in blanks, underline or circle the correct answers. Send top three copies to Kansas Department of Health and Environment, Bureau of Water, Geology Section, 1000 SW Jackson St., Ste. 420, Topeka, Kansas 66612-1367. Telephone: 785/296-5522. Send one to Water Well Owner and retain one for your records.																													