

County: Gray Fraction: NE N NE SW Sec. 24 T. 28 S R. 29 W

CORRECTION(S) to WATER WELL COMPLETION RECORD Form WWC-5 (to rectify lacking or incorrect information)

Owner: Pride Ag Resources MW R6

If location corrected, was listed as:

Location changed to:

Section-Township-Range: _____

Fraction (1/4 calls): _____

Other changes: Initial statements: The depth of this well is identical to MW 5 (549848) at 143.21', but in the lithology section we can see the deepest part of this well is 144.8'.

Changed to: I have changed the depth of the well to 144.8 to match.

Comments: The original depth was mostly likely a typo.

Verification method: I have reached out to Pam Chaffee at the KDHE to verify, and will amend this further if necessary.


Initials: BK Date: 1-10-2022

Submitted by: Kansas Geological Survey, Data Resources Library, 1930 Constant Ave., Lawrence, KS 66047-3724
 Kansas Dept. of Health & Environment, Bureau of Water, 1000 SW Jackson, Suite 420, Topeka, KS 66612-1367

1 LOCATION OF WATER WELL: Fraction NE 1/4 N 1/4 NE 1/4 SW 1/4 Section Number 24 Township Number T 28 S Range Number 29 E W
 County: Gray

Street/Rural Address of Well Location; if unknown, distance & direction from nearest town or intersection: If at owner's address, check here 400 West Texco (Hwy56) Montezuma, KS
Global Positioning Systems (GPS) information:
 Latitude: 37.598523 (in decimal degrees)
 Longitude: 100.445995 (in decimal degrees)
 Elevation: 2782
 Horizontal Datum: WGS84, NAD83, NAD27
 Collection Method:

2 WATER WELL OWNER: Pride Ag Resources
 RR#, St. Address, Box #: 710 West Trail St
 City, State ZIP Code: Dodge City, KS 67801
 GPS unit (Make/Model: _____)
 Digital Map/Photo, Topographic Map, Land Survey
 Est. Accuracy: < 3 m, 3-5 m, 5-15 m, > 15 m

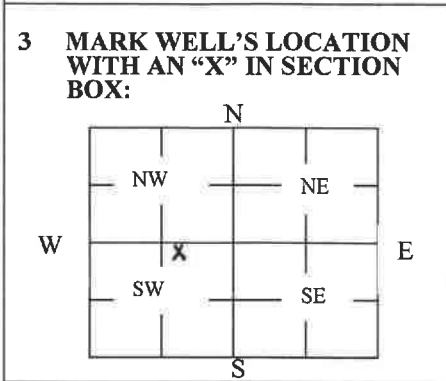

4 DEPTH OF WELL 143.21 ft.
 WELL'S STATIC WATER LEVEL 122.04 ft
 WELL WAS USED AS:
 Domestic Public Water Supply Dewatering
 Irrigation Oil Field Water Supply Monitoring
 Feedlot Domestic (Lawn & Garden) Injection Well
 Industrial Air Conditioning Other _____
 Was a chemical/bacteriological sample submitted to Department? Yes No

5 TYPE OF BLANK CASING USED:
 Steel RMP (SR) Wrought Fiberglass Other (Specify below) _____
 PVC ABS Asbestos-Cement Concrete Tile
 Blank casing diameter 4 in. Was casing pulled? Yes No If yes, how much _____
 Casing height above or below land surface -36 in.

6 GROUT PLUG MATERIAL: Neat cement Cement grout Bentonite Other _____
 Grout Plug Intervals: From 144.8 ft. to 105.0 ft., From 50.12 ft. to 2.90 ft., From _____ ft. to _____ ft.
 What is the nearest source of possible contamination:
 Septic tank Seepage pit Fuel storage Other (specify below) _____
 Sewer lines Pit privy Fertilizer storage _____
 Watertight sewer lines Sewage lagoon Insecticide storage _____
 Lateral lines Feedyard Abandoned water well Oil well/Gas well
 Cess pool Livestock pens Direction from well? Southwest
 How many feet? 500

FROM	TO	PLUGGING MATERIALS	FROM	TO	PLUGGING MATERIALS
144.80	105.07	Bentonite			
105.07	50.12	Local sand			
50.12	2.90	Bentonite			

7 CONTRACTOR'S OR LANDOWNER'S CERTIFICATION: This water well was plugged under my jurisdiction and was completed on (mo/day/year) 8/27/2021 and this record is true to the best of my knowledge and belief. Kansas Water Well Contractor's License No. 39315 929. This Water Well Record was completed on (mo/day/year) 9/2/2021 under the business name of Southwest Environmental Engineering LLC by (signature) [Signature]

Send one white copy to Kansas Department of Health & Environment, Geology Section, 1000 SW Jackson Street, Ste. 420, Topeka, KS 66612-1367. Send one copy to WATER WELL OWNER and retain one for your records.
 Visit us at <http://www.kdheks.gov/waterwell/index.html> Telephone 785-296-5524.

