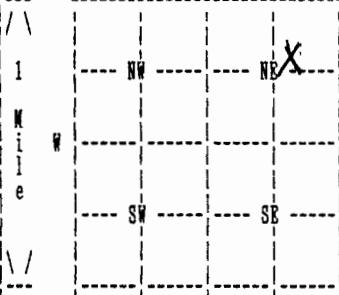


WATER WELL RECORD Form WWC-5 KSA 82a-1212

1 LOCATION OF WATER WELL: COUNTY: GRAY		Fraction SW 1/4 NE 1/4 NE 1/4	Section Number 6	Township Number T 28 S	Range Number R 29 W	
Distance and direction from nearest town or city street address of well if located within city? FROM MONTEZUMA, KS. - 3 1/2 NORTH, 4 WEST AND 1/4 SOUTH	
2 WATER WELL OWNER: RR#, St. Address, Box # : ROUTE #2 City, State, ZIP code : MONTEZUMA, KS 67867-		Board of Agriculture, Division of Water Resources Application Number:	
3 LOCATE WELL'S LOCATION WITH AN "X" IN SECTION BOX:		4 DEPTH OF COMPLETED WELL 360 ELEVATION: 0 Depth(s) Groundwater Encountered 1. 0 ft. 2. 0 ft. 3. 0 ft.	
		WELL'S STATIC WATER LEVEL 241 ft. below land surface measured on mo/day/yr 07/13/94 Pump test data: Well water was 0 ft. after 0 hours pumping 0 gpm Estimated Yield 40 gpm: Well water was 0 ft. after 0 hours pumping 0 gpm Bore Hole Diameter 9 in. to 360 ft., and in. to 0 ft. WELL WATER TO BE USED AS: DOMESTIC Was a chemical/bacteriological sample submitted to department? No ; If yes, mo/day/yr sample was submitted Water well disinfected? Yes	
5 TYPE OF BLANK CASING USED: PVC CASING JOINTS: GLUED Blank casing diameter 5 in. to 360 ft., Dia in. to 0 ft., Dia in. to 0 ft. Casing height above land surface 12 in., weight 200 lbs/ft. Wall thickness or gauge No. 21 TYPE OF SCREEN OR PERFORATION MATERIAL: PVC SCREEN OR PERFORATION OPENINGS ARE: SAW CUT	
SCREEN PERFORATED INTERVALS: From 300 ft. to 340 ft., From 0 ft. to 0 ft. From 0 ft. to 0 ft., From 0 ft. to 0 ft. GRAVEL PACK INTERVALS: From 30 ft. to 360 ft., From 0 ft. to 0 ft. From 0 ft. to 0 ft., From 0 ft. to 0 ft.	
6 GROUT MATERIAL BENTONITE Grout Intervals: From 0 ft. to 30 ft., From 0 ft. to 0 ft., From 0 ft. to 0 ft. What is the nearest source of possible contamination: ABANDONED WELL Direction from well? SOUTH How many feet? 14	
<table border="1"> <thead> <tr> <th>FROM</th> <th>TO</th> <th>LITHOLOGIC LOG</th> <th>FROM</th> <th>TO</th> <th>PLUGGING INTERVALS</th> </tr> </thead> <tbody> <tr> <td>0</td> <td>25</td> <td>TOPSOIL FINE SAND CLAY</td> <td></td> <td></td> <td></td> </tr> <tr> <td>25</td> <td>40</td> <td>FINE SAND</td> <td></td> <td></td> <td></td> </tr> <tr> <td>40</td> <td>75</td> <td>SANDY CLAY</td> <td></td> <td></td> <td></td> </tr> <tr> <td>75</td> <td>130</td> <td>SAND GRAVEL</td> <td></td> <td></td> <td></td> </tr> <tr> <td>130</td> <td>180</td> <td>CALACHIE ROCK CLAY</td> <td></td> <td></td> <td></td> </tr> <tr> <td>180</td> <td>240</td> <td>CLAY FINE SAND</td> <td></td> <td></td> <td></td> </tr> <tr> <td>240</td> <td>290</td> <td>SANDY BROWN CLAY</td> <td></td> <td></td> <td></td> </tr> <tr> <td>290</td> <td>335</td> <td>MEDIUM SAND</td> <td></td> <td></td> <td></td> </tr> <tr> <td>335</td> <td>340</td> <td>SANDY CLAY</td> <td></td> <td></td> <td></td> </tr> <tr> <td>340</td> <td>358</td> <td>MEDIUM SAND FINE SAND</td> <td></td> <td></td> <td></td> </tr>
7 CONTRACTOR'S OR LANDOWNER'S CERTIFICATION: This water well was Constructed under my jurisdiction and was completed on (mo/day/year) 07/13/94 and this record is true to the best of my knowledge and belief. Kansas Water Well Contractor's License No. 179 This Water Well Record was completed on (mo/day/yr) 07/28/94 under the business name of JOE'S WELL SERVICE, INC. by (signature) <i>Joe's Well Service</i>	

(Continued)

WATER WELL RECORD Form WWC-5 KSA 82a-1212

1 LOCATION OF WATER WELL: COUNTY: GRAY		Fraction SW 1/4 NE 1/4 NE 1/4	Section Number 6	Township Number T 28 S	Range Number R 29 W												
2 WATER WELL OWNER: RR#, St. Address, Box # : ROUTE #2 City, State, ZIP code : MONTEZUMA, KS 67867-		Board of Agriculture, Division of Water Resources Application Number:															
<table border="1"> <thead> <tr> <th>FROM</th> <th>TO</th> <th>LITHOLOGIC LOG</th> <th></th> <th></th> <th></th> </tr> </thead> <tbody> <tr> <td>358</td> <td>363</td> <td>BROWN CLAY</td> <td></td> <td></td> <td></td> </tr> </tbody> </table>						FROM	TO	LITHOLOGIC LOG				358	363	BROWN CLAY			
FROM	TO	LITHOLOGIC LOG															
358	363	BROWN CLAY															