

1 LOCATION OF WATER WELL:	Fraction	Section Number	Township Number	Range Number
County: <i>Gray</i>	<i>SW 1/4 SW 1/4 NW 1/4</i>	<i>36</i>	<i>T 28 S</i>	<i>R 29 E</i>

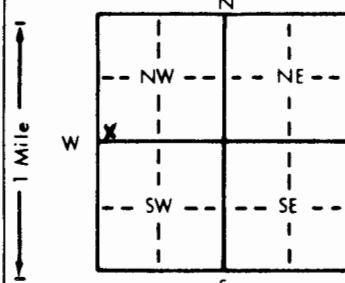
Distance and direction from nearest town or city street address of well if located within city?

*From Montezuma west edge 1 1/2 miles South.*2 WATER WELL OWNER: *Jeff Schmidt*RR#, St. Address, Box # : *P.O. Box 231*City, State, ZIP Code : *Montezuma, KS 67867*

Board of Agriculture, Division of Water Resources

Application Number:

3 LOCATE WELL'S LOCATION WITH AN "X" IN SECTION BOX:

4 DEPTH OF COMPLETED WELL: *170'* ft. ELEVATION:

Depth(s) Groundwater Encountered 1. ft. 2. ft. 3. ft.

WELL'S STATIC WATER LEVEL: *110'* ft. below land surface measured on mo/day/yr *8-26-94*

Pump test data: Well water was ft. after hours pumping gpm

Est. Yield gpm: Well water was ft. after hours pumping gpm

Bore Hole Diameter: *9 1/8"* in. to ft. and in. to ft.

WELL WATER TO BE USED AS: 5 Public water supply 8 Air conditioning 11 Injection well

1 Domestic 3 Feedlot 6 Oil field water supply 9 Dewatering 12 Other (Specify below)

2 Irrigation 4 Industrial 7 Lawn and garden only 10 Monitoring well

Was a chemical/bacteriological sample submitted to Department? Yes No If yes, mo/day/yr sample was submittedWater Well Disinfected? Yes No

5 TYPE OF BLANK CASING USED:

1 Steel 3 RMP (SR)

 PVC 4 ABS

5 Wrought iron

6 Asbestos-Cement

7 Fiberglass

8 Concrete tile

9 Other (specify below)

CASING JOINTS: Glued Clamped

Welded

Threaded

Blank casing diameter: *5"* in. to ft., Dia. in. to ft., Dia. in. to ft.Casing height above land surface: *12"* in. weight lbs./ft. Wall thickness or gauge No. *SDR 21*

TYPE OF SCREEN OR PERFORATION MATERIAL:

1 Steel 3 Stainless steel

2 Brass 4 Galvanized steel

5 Fiberglass

6 Concrete tile

8 RMP (SR)

9 ABS

7 PVC

10 Asbestos-cement

11 Other (specify)

12 None used (open hole)

SCREEN OR PERFORATION OPENINGS ARE:

5 Gauzed wrapped

6 Wire wrapped

7 Torch cut

8 Saw cut

9 Drilled holes

10 Other (specify)

11 None (open hole)

SCREEN-PERFORATED INTERVALS: From: *130'* ft. to *170'* ft., From:

From:

From:

GRAVEL PACK INTERVALS: From: *24'* ft. to *170'* ft., From:

From:

From:

6 GROUT MATERIAL: 1 Neat cement 2 Cement grout 3 Bentonite 4 OtherGrout Intervals: From: *4'* ft. to *24'* ft., From:

10 Livestock pens

14 Abandoned water well

11 Fuel storage

15 Oil well/Gas well

12 Fertilizer storage

16 Other (specify below)

Nothing at present

13 Insecticide storage











