

WATER WELL RECORD

Form WWC-5

KSA 82a-1212

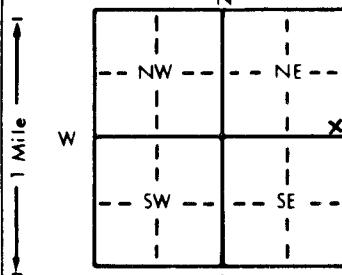
1 LOCATION OF WATER WELL:	Fraction County: <u>Gray</u>	<u>SE 1/4</u>	<u>SE 1/4</u>	<u>NE 1/4</u>	Section Number 9	Township Number T 28 S	Range Number R 29 EW
---------------------------	---------------------------------	---------------	---------------	---------------	---------------------	---------------------------	-------------------------

Distance and direction from nearest town or city street address of well if located within city?

From Montezuma, 1 1/2 miles north on Tagall's blk. top, 2 miles west, 1/2 north

2 WATER WELL OWNER:	Glenn Banach	RR#, St. Address, Box # :	08902 AARD.	Board of Agriculture, Division of Water Resources
City, State, ZIP Code	Montezuma, KS 67867			Application Number:

3 LOCATE WELL'S LOCATION WITH AN "X" IN SECTION BOX:	4 DEPTH OF COMPLETED WELL 195' ft. ELEVATION:
--	---

	Depth(s) Groundwater Encountered 1. ft. 2. ft. 3. ft.
	WELL'S STATIC WATER LEVEL 164' ft. below land surface measured on mo/day/yr 3-31-95
Pump test data: Well water was ft. after hours pumping gpm	
Est. Yield gpm: Well water was ft. after hours pumping gpm	
Bore Hole Diameter 9 1/8 in. to ft., and in. to ft.	
WELL WATER TO BE USED AS: 5 Public water supply 8 Air conditioning 11 Injection well	
1 Domestic 3 Feedlot 6 Oil field water supply 9 Dewatering 12 Other (Specify below)	
2 Irrigation 4 Industrial 7 Lawn and garden only 10 Monitoring well	
Was a chemical/bacteriological sample submitted to Department? Yes No <input checked="" type="checkbox"/> ; If yes, mo/day/yr sample was submitted	
Water Well Disinfected? Yes <input checked="" type="checkbox"/> No	

5 TYPE OF BLANK CASING USED:	5 Wrought iron 8 Concrete tile Casing joints: Glued <input checked="" type="checkbox"/> Clamped
1 Steel 3 RMP (SR)	6 Asbestos-Cement 9 Other (specify below) Welded
2 PVC <input checked="" type="checkbox"/> 4 ABS	7 Fiberglass Threaded

Blank casing diameter 5 1/2 in. to 155' ft., Dia in. to ft., Dia in. to ft.

Casing height above land surface 12' in., weight lbs./ft. Wall thickness or gauge No. 50R-21

TYPE OF SCREEN OR PERFORATION MATERIAL:	7 PVC
1 Steel 3 Stainless steel 5 Fiberglass 8 RMP (SR)	10 Asbestos-cement
2 Brass 4 Galvanized steel 6 Concrete tile 9 ABS	11 Other (specify)
12 None used (open hole)	

SCREEN OR PERFORATION OPENINGS ARE:	5 Gauzed wrapped 8 Saw cut 11 None (open hole)
1 Continuous slot 3 Mill slot 6 Wire wrapped 9 Drilled holes	
2 Louvered shutter 4 Key punched 7 Torch cut 10 Other (specify)	

SCREEN-PERFORATED INTERVALS: From 155' ft. to 195' ft., From ft. to ft.

From ft. to ft., From ft. to ft.

GRAVEL PACK INTERVALS: From 24' ft. to 195' ft., From ft. to ft.

From ft. to ft., From ft. to ft.

6 GROUT MATERIAL:	1 Neat cement 2 Cement grout 3 Bentonite 4 Other
Grout Intervals: From 4' ft. to 24' ft., From ft. to ft., From ft. to ft.	

What is the nearest source of possible contamination:

1 Septic tank 4 Lateral lines 7 Pit privy 10 Livestock pens 14 Abandoned water well	
2 Sewer lines 5 Cess pool 8 Sewage lagoon 11 Fuel storage 15 Oil well/Gas well	
3 Watertight sewer lines 6 Seepage pit 9 Feedyard 12 Fertilizer storage 16 Other (specify below)	
13 Insecticide storage None	

Direction from well?

FROM	TO	LITHOLOGIC LOG	FROM	TO	PLUGGING INTERVALS
0	2	Topsoil			
2	42	Brown clay			
42	52	Brown sandy clay			
52	85	Brown clay			
85	102	Med. sand			
102	108	Brown clay			
108	130	Med. sand & calcareous layers			
130	140	Brown clay			
140	158	Med. sand & brown clay layers			
158	159	Sandrock			
159	177	Med. sand & brown clay layers			
177	178	Sandrock			
178	192	Sandrock layers & brown sand, clay			
192	195	Shale			

7 CONTRACTOR'S OR LANDOWNER'S CERTIFICATION: This water well was (1) constructed, (2) reconstructed, or (3) plugged under my jurisdiction and was completed on (mo/day/year) 3-31-95 and this record is true to the best of my knowledge and belief. Kansas

Water Well Contractor's License No. 533 This Water Well Record was completed on (mo/day/yr) 4-17-95

under the business name of Tantzen Water Well Repair by (signature) 