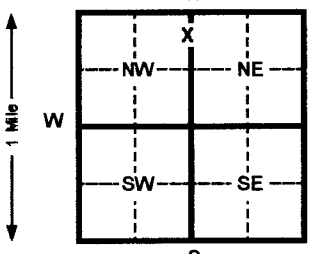


1 LOCATION OF WATER WELL:		Fraction	Section Number		Township Number		Range Number							
County: SEDGWICK		NE ¼ SE ¼ NW ¼	1		T 28S S		R 3W EW							
Distance and direction from nearest town or city street address of well if located within city? 3615 S. 222ND; GODDARD														
2 WATER WELL OWNER: TIM ABBOTT CONST.														
RR#, St. Address, Box # : 3615 S. 222ND														
City, State, ZIP Code : GODDARD, KS Application Number:														
3 LOCATE WELL'S LOCATION WITH AN "X" IN SECTION BOX:			4 DEPTH OF COMPLETED WELL 60 ft. ELEVATION:											
			Depth(s) Groundwater Encountered 1 31 ft. 2 _____ ft. 3 _____ ft.											
			WELL'S STATIC WATER LEVEL 31 ft. below land surface measured on mo/day/yr 10-17-03											
			Pump test data: Well water was _____ ft. after _____ hours pumping _____ gpm											
			Est. Yield _____ gpm: Well water was _____ ft. after _____ hours pumping _____ gpm											
			Bore Hole Diameter 10 in. to 60 ft. and _____ in. to _____ ft.											
			WELL WATER TO BE USED AS: 5 Public water supply 8 Air conditioning 11 Injection well											
			1 Domestic 3 Feed lot 6 Oil field water supply 9 Dewatering 12 Other (Specify below)											
			2 Irrigation 4 Industrial 7 Lawn and garden (domestic) 10 Monitoring well											
			Was a chemical/bacteriological sample submitted to Department? Yes _____ No X If yes, mo/day/yr sample was submitted _____											
			Water Well Disinfected? Yes X No _____											
5 TYPE OF BLANK CASING USED:														
1 Steel			3 RMP (SR)			5 Wrought Iron			8 Concrete tile			CASING JOINTS: Glued X Clamped _____		
2 PVC			4 ABS			6 Asbestos-Cement			9 Other (specify below)			Welded _____		
						7 Fiberglass						Threaded _____		
Blank casing diameter 5 in. to 60 ft., Dia _____ in. to _____ ft., Dia _____ in. to _____ ft.														
Casing height above land surface 16 in., weight 160 lbs./ft. Wall thickness or gauge No. 26														
TYPE OF SCREEN OR PERFORATION MATERIAL:														
1 Steel			3 Stainless steel			5 Fiberglass			7 PVC			10 Asbestos-cement		
2 Brass			4 Galvanized steel			6 Concrete tile			9 ABS			11 Other (specify) _____		
SCREEN OR PERFORATION OPENINGS ARE:									8 Saw cut			11 None (open hole)		
1 Continuous slot			3 Mill slot			6 Wire wrapped			9 Drilled holes					
2 Louvered shutter			4 Key punched			7 Torch cut			10 Other (specify) _____					
SCREEN-PERFORATED INTERVALS: From 50 ft. to 60 ft. From _____ ft. to _____ ft.														
GRAVEL PACK INTERVALS: From 24 ft. to 60 ft. From _____ ft. to _____ ft.														
6 GROUT MATERIAL: 1 Neat cement 2 Cement grout 3 Bentonite 4 Other _____														
Grout intervals From 4 ft. to 24 ft. From _____ ft. to _____ ft. From _____ ft. to _____ ft.														
What is the nearest source of possible contamination:														
1 Septic tank			4 Lateral lines			7 Pit privy			10 Livestock pens			14 Abandoned water well		
2 Sewer lines			5 Cess pool			8 Sewage lagoon			11 Fuel storage			15 Oil well/ Gas well		
3 Watertight sewer lines			6 Seepage pit			9 Feedyard			12 Fertilizer storage			16 Other (specify below)		
Direction from well? EAST How many feet? 40														
FROM		TO		CODE		LITHOLOGIC LOG		FROM		TO		PLUGGING INTERVALS		
0		3				TOPSOIL								
3		24				CLAY								
24		32				GREEN SHALE								
32		45				BLUE SHALE								
45		51				RED SHALE								
51		60				BLUE SHALE								
7 CONTRACTOR'S OR LANDOWNER'S CERTIFICATION: This water well was (1 constructed, 2 reconstructed, or (3) plugged under my jurisdiction and was completed on (mo/day/yr) 10-17-03 and this record is true to the best of my knowledge and belief. Kansas														
Water Well Contractor's License No. 611 This Water Well Record was completed on (mo/day/yr) 10-17-03														
under the business name of Chase Drilling by (signature) RICK CHASE														
INSTRUCTIONS: Please fill in blanks and circle the correct answers. Send three copies to Kansas Department of Health and Environment, Bureau of Water, 1000 SW Jackson St., Ste. 420, Topeka, Kansas 66612-1367. Telephone: 913-296-5545. Send one to WATER WELL OWNER and retain one for your records.														

OFFICE USE ONLY

T

२

SEC