

1	LOCATION OF WATER WELL:	Fraction	Section Number	Township Number	Range Number
County:	<i>Polk</i>	<i>SE 1/4 NW 1/4 NE 1/4</i>	<i>13</i>	<i>T 28 S</i>	<i>R 3 E</i>

Distance and direction from nearest town or city street address of well if located within city?


22201 Elk Pass.

2] WATER WELL OWNER: *Greg Freibus.*
RR#, St. Address, Box # : *22201 Elk Pass.*
City, State, ZIP Code : *Goddard, Ks. 67052*

Board of Agriculture, Division of Water Resources
Application Number:

3 LOCATE WELL'S LOCATION WITH 4 DEPTH OF COMPLETED WELL 53

AN "X" IN SECTION BOX:

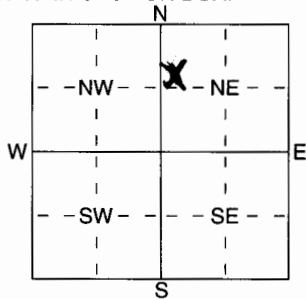

Depth(s) Groundwater Encountered 1 ft. 2 ft. 3 ft.
WELL'S STATIC WATER LEVEL 21 ft. below land surface measured on mo/day/yr
Pump test data: Well water was ft. after hours pumping gpm
Est. Yield 25 gpm Well water was ft. after hours pumping gpm
WELL WATER TO BE USED AS: 5 Public water supply 8 Air conditioning 11 Injection well
1 Domestic 3 Feedlot 6 Oil field water supply 9 Dewatering 12 Other (Specify below)
2 Irrigation 4 Industrial 7 Domestic (lawn & garden) 10 Monitoring well

Was a chemical/bacteriological sample submitted to Department? Yes No X; If yes, mo/day/hrs sample was submitted
Water Well Disinfected? Yes X No

5	TYPE OF BLANK CASING USED:
---	----------------------------

1 Steel
2 PVC
3 RMP (SR)
4 ABS
5 _____
6 Asbestos-Cement
7 Fiberglass
8 _____
9 Other (specify below) _____
Welded _____
Threaded _____

Blank casing diameter 5" in. to 35" ft. Dia 5" in. to 35" ft. Dia 5" in. to 35" ft.
Casing height above land surface 13" in., weight 2.17 lbs./ft. Wall thickness or gauge No. 160 PSI

TYPE OF SCREEN OR PERFORATION MATERIAL:

1 Steel	3 Stainless Steel	5 Fiberglass	8 RMP (SR)	11 Other (Specify)
2 Brass	4 Galvanized Steel	6 Concrete tile	9 ABS	12 None used (open hole)

SCREEN OR PERFORATION OPENINGS ARE:

1 Continuous slot 3 Mill slot 6 Wire wrapped 9 Drilled holes
2 Louvered shutter 4 Key punched 7 Torch cut 10 Other (specify) _____ ft.

SCREEN-PERFORATED INTERVALS: From 35 ft. to 53 ft. From _____ ft. to _____ ft.
From _____ ft. to _____ ft. From _____ ft. to _____ ft.

GRAVEL PACK INTERVALS:

6 GROUT MATERIAL: 1 Neat cement 2 Cement grout 3 Bentonite 4 Other.....

Grout Intervals: From 1 ft. to 21 ft., From ft. to ft., From ft. to ft.

What is the nearest source of possible contamination:

1 Septic tank	4 Lateral lines	7 Pit privy	11 Fuel storage	15 Oil well/Gas well
2 Sewer lines	5 Cess pool	8 Sewage lagoon	12 Fertilizer storage	16 Other (specify below)
3 Watertight sewer lines	6 Seepage pit	9 Feedyard	13 Insecticide storage	

Direction from well? South

[illegible]

CONTRACTOR'S OR LANDOWNER'S CERTIFICATION: This water well was (1) constructed, (2) reconstructed, or (3) plugged under my jurisdiction and was completed on (mo/day/year) 4-24-05 and this record is true to the best of my knowledge and belief. Kansas Water Well Contractor's Licence No. #740 This Water Well Record was completed on (mo/day/yr) 5-5-05 under the business name of Wenix Drilling Inc. by (signature) [Signature]