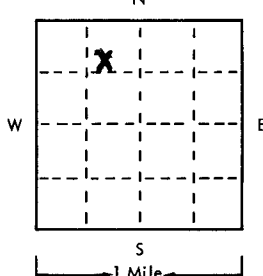
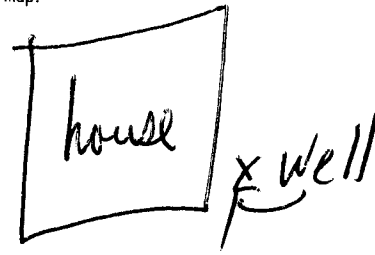


USE TYPEWRITER OR BALL
POINT PEN-PRESS FIRMLY,
PRINT CLEARLY.

WATER WELL RECORD
KSA 82a-1201-1215

T R EW sec 1/4 1/4 1/4 No.

Kansas State Dept. Of Health
(Water Well Contractors)
Forbes-Bldg. 740
Topeka, Kansas 66620

1 Location of well:	County <u>Sedg.</u>	Township name <u>Afton</u>	Fraction <u>NW-1/4-E-NW</u>	Section number <u>14</u>	Town number <u>28S</u>	Range number <u>3W</u>
Distance and direction from nearest town or city: <u>East 3.50 1/2 E Garden Plain KS.</u>				3 Owner of well: <u>Dick Kline</u>		
Street address of well location if in city: <u>4207 Chesapeake Rd.</u>				Address: <u>298 No West St. Wichita, KS 67212</u>		
Locate with "X" in section below:		Sketch map:		4 Well depth: <u>95</u> ft. Date of completion: <u>11/31/77</u> Well diameter: <u>5</u> in. <u>11"</u>		
				5 ☐ Cable tool ☒ Rotary ☐ Driven ☐ Dug ☐ Hollow rod ☐ Jetted ☐ Bored ☐ Reverse rotary		
2 Type and color of material		From To		6 Use: ☒ Domestic ☐ Public supply ☐ Industry ☐ Irrigation ☐ Air conditioning ☐ Commercial ☐ Test well		
				7 Casing: Material <u>PR</u> Height: above/below Threaded ☐ Welded ☒ Surface <u>12</u> in. Diam. <u>5</u> in. Weight <u>23</u> lbs./ft. <u>160</u> <u>5</u> in. to <u>95</u> ft. depth Drive shoe? ☐ Yes ☒ No		
				8 Screen: Manufacturer <u>Pumpco MARI</u> Type <u>PR</u> Dia. <u>5</u> in. Slot/pause <u>1/8</u> Length <u>50</u> ft. Set between <u>45</u> ft. and <u>95</u> ft. Fittings: <u>3/8</u> Gravel pack ☒ Yes ☐ No Size range of material: <u>3/8</u>		
				9 Static water level: <u>35</u> ft. below land surface Date <u>11/31/77</u>		
				10 Pumping level below land surfaces: <u>50</u> ft. after <u>12</u> hrs. pumping <u>20</u> g.p.m. ____ ft. after ____ hrs. pumping ____ g.p.m. Estimated maximum yield <u>22</u> g.p.m.		
(use a second sheet if needed)				11 Water sample submitted: ☐ Yes ☒ No Date ____		
				12 Well head completion: ☒ Pitless adapter <u>12</u> inches above grade		
				13 Well grouted? ☒ Yes ☐ No ☒ Neat cement ☐ Bentonite ☐ ____ Depth: From <u>3</u> ft. to <u>13</u> ft.		
				14 Nearest source of possible contamination: <u>1/4 mile</u> Direction <u>W.</u> Type <u>lake</u> . Well disinfected upon completion? ☒ Yes ☐ No		
				15 Pump: ☐ Not installed Manufacturer's name <u>Valley</u> Model number <u>1809</u> HP <u>3/4</u> Volt <u>220</u> Length of drop pipe <u>80</u> ft. capacity <u>20</u> g.p.m. Type: ☒ Submersible ☐ Turbine ☐ Jet ☐ Reciprocating ☐ Centrifugal ☐ Other		
16 Remarks: elevation <u>Contractor to furnish 4x4x4 reinforced slab.</u>		17 Water well contractor's certification: This well was drilled under my jurisdiction and this report is true to the best of my knowledge and belief. <u>Weninger Building</u> 318 Business name <u>Calbrech K</u> License No. ____ Address <u>Wichita, KS</u> Date <u>11/31/77</u> <u>James Weninger</u> Authorized representative				

Forward the white, blue and pink copies to the Kansas State Dept. Of Health.

Form WWC-5