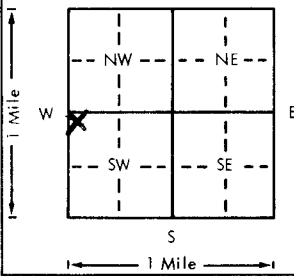
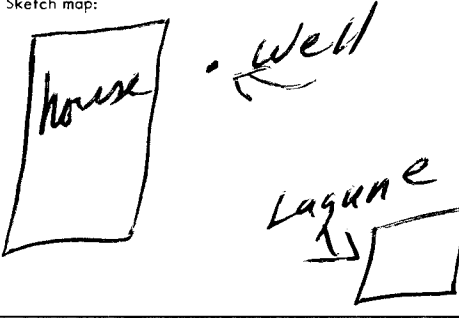


USE TYPEWRITER OR BALL
POINT PEN-PRESS FIRMLY,
PRINT CLEARLY.

WATER WELL RECORD
KSA 82a-1201-1215

Kansas Department of Health and
Environment-Division of Environment
(Water well Contractors)
Topeka, Kansas 66620

1. Location of well:		County: <u>Sedgwick</u>	Fraction: <u>NW 1/4 NW 1/4 SW 1/4</u>	Section number: <u>12</u>	Township number: <u>T 28 S</u>	Range number: <u>R 3 W</u>
2. Distance and direction from nearest town or city: <u>2 W 2 1/2 So Goddard KS</u> Street address of well location if in city: <u>3410 So 231st. West.</u>				3. Owner of well: <u>Kurt Foley</u> R.R. or street: <u>1837 E. English</u> City, state, zip code: <u>Wichita KS 67211</u>		
4. Locate with "X" in section below:		Sketch map:		6. Bore hole dia. <u>11</u> in. Completion date <u>3-10-80</u> Well depth <u>94</u> ft.		
				7. Cable tool ☒ Rotary ☐ Driven ☐ Dug ☐ Hollow rod ☐ Jetted ☐ Bored ☐ Reverse rotary		
5. Type and color of material				8. Use: ☒ Domestic ☐ Public supply ☐ Industry ☐ Irrigation ☐ Air conditioning ☐ Stock ☐ Lawn ☐ Oil field water ☐ Other		
				9. Casing: Material <u>Supers</u> Height Above or below Threaded ☒ Welded ☒ Surface <u>12</u> in. RMP ☒ PVC ☒ Weight <u>1.50</u> lbs./ft. Dia. <u>5</u> in. to <u>94</u> ft. depth Wall Thickness: inches or Dia. <u>5</u> in. to <u>94</u> ft. depth gage No. <u>1200</u>		
				10. Screen: Manufacturer's name <u>Cornac</u> Type <u>200</u> Dia. <u>5 1/2</u> Slot gauge <u>1/16</u> Length <u>60 ft</u> Set between <u>34</u> ft. and <u>94</u> ft. Gravel pack <u>yes</u> Size range of material <u>1/8-3/8</u>		
				11. Static water level: <u>34</u> ft. below land surface Date <u>3/10/80</u> mo./day/yr.		
				12. Pumping level below land surfaces: <u>59</u> ft. after <u>1/2</u> hrs. pumping <u>10</u> g.p.m. <u>59</u> ft. after <u>1/2</u> hrs. pumping <u>10</u> g.p.m. Estimated maximum yield <u>15-20</u> g.p.m.		
				13. Water sample submitted: <u>Yes</u> ☒ No ☐ Date <u>3/10/80</u> mo./day/yr.		
				14. Well head completion: <u>12</u> inches above grade ☒ Pitless adapter		
				15. Well grouted? <u>yes</u> With: <u>Neat cement</u> ☒ Bentonite ☒ Concrete ☐ Depth: From <u>3</u> ft. to <u>13</u> ft.		
				16. Nearest source of possible contamination: ft. <u>100</u> Direction <u>SE</u> Type <u>Lagune</u> Well disinfected upon completion? ☒ Yes ☐ No		
				17. Pump: <u>Not installed</u> Manufacturer's name <u>McDonough</u> Model number <u>1808</u> HP <u>3/4</u> Volts <u>220</u> Length of drop pipe <u>80</u> ft. capacity <u>12</u> g.p.m. Type: ☒ Submersible ☐ Turbine ☐ Jet ☐ Reciprocating ☐ Centrifugal ☐ Other		
18. Elevation:		19. Remarks:		20. Water well contractor's certification: This well was drilled under my jurisdiction and this report is true to the best of my knowledge and belief. <u>Alviner Pullen</u> <u>3/10/80</u> Business name <u>Polovich</u> License No. <u>3110/80</u> Address <u>3110/80</u> Signature <u>Alviner Pullen</u> Date <u>3/10/80</u> Authorized representative		

Forward the white, blue and pink copies to the Department of Health and Environment

Form WWC-5