Sent 2-21-77

USE TYPEWRITER OR BALL POINT PEN-PRESS FIRMLY, PRINT CLEARLY.

T R EW sec 1/4 1/4 1/4 No.

WATER WELL RECORD
KSA 82a-1201-1215

Kansas State Dept. Of Health
(Water Well Contractors)
Forbes-Bldg. 740
Topeka, Kansas 66620

1 Location of well:	County	Township name	Fraction	Section number	Town number	Range number
	Sedg	AFTON	NENENE	21	28S	3W.

Distance and direction from nearest town or city: 8 miles NE of Viola Ks.
Street address of well location if in city: on Viola Rd

3 Owner of well: Ralph C Cramm
Address: 997 N Robinson Rd Wichita Ks.

Locate with "X" in section below:

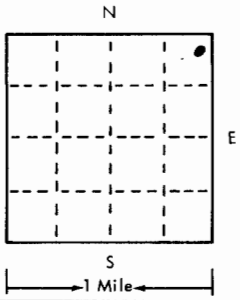

Sketch map:

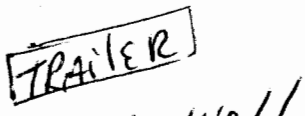

4 Well depth: 95 ft. Date of completion 11/27
Well diameter 5 in.

5 ☐ Cable tool ☒ Rotary ☐ Driven ☐ Dug
☐ Hollow rod ☐ Jetted ☐ Bored ☐ Reverse rotary

6 Use: ☒ Domestic ☐ Public supply ☐ Industry
☐ Irrigation ☐ Air conditioning ☐ Commercial
☐ Test well ☐ ____

7 Casing: Material Rmp Height: above/below
Threaded ☐ Welded ☒ Surface 12 in.
Diam. 5 in. to 95 ft. depth Weight 150 lbs./ft 100
Drive shoe? ☐ Yes ☒ No
___ in. to ___ ft. depth

8 Screen:
Manufacturer Sunflower.
Type Plastic Dia. 5 in.
Slot/gauze 18 Length 50'
Set between 45 ft. and 95 ft.
Fittings:
Gravel pack ☒ Yes ☐ No Size range of material 3/8

2 Type and color of material	From	To
Top Soil - Red.	0	4
fine to med. sand.	4	18
Blue Clay & shale	18	48
Blue Shale.	48	60
Shale (Blue) and clay	60	75
Blue & gray shale mixed	75	95.
(use o second sheet if needed)		

9 Static water level:
35 ft. below land surface Date 11/27

10 Pumping level below land surfaces:
40 ft. after 3 hrs. pumping 18 g.p.m.
___ ft. after ___ hrs. pumping ___ g.p.m.
Estimated maximum yield ___ g.p.m.

11 Water sample submitted:
☐ Yes ☒ No Date ___

12 Well head completion:
☐ Pitless adapter ☒ 12 inches above grade

13 Well grouted? ☒ Yes ☐ No
☐ Neat cement ☐ Bentonite ☒ Concrete
Depth: From 3 ft. to 13 ft. → MNC

14 Nearest source of possible contamination:
ft. None Direction ___ Type ___
Well disinfected upon completion? ☒ Yes ☐ No

15 Pump: ☐ Not installed
Manufacturer's name Valley
Model number 180 HP 1½ Volts 230
Length of drop pipe 80 ft. capacity 15 g.p.m.
Type:
☒ Submersible ☐ Turbine
☐ Jet ☐ Reciprocating
☐ Centrifugal ☐ Other

16 Remarks: elevation

Topography:
☒ Hill
☐ Slope
☐ Upland
☐ Valley

17 Water well contractor's certification:
This well was drilled under my jurisdiction and this report is true to the best of my knowledge and belief.
Business name Clemmer Well Service License No. 318
Address R 1 Colwich Ks
Signed [signature] Date 11/27
Authorized representative

Forward the white, blue and pink copies to the Kansas State Dept. Of Health.

Form WWC-5

677-H

28 3W 21 NE NE