USE TYPEWRITER OR BALL POINT PEN-PRESS FIRMLY, PRINT CLEARLY.

WATER WELL RECORD
KSA 82a-1201-1215

Kansas Department of Health and Environment-Division of Environment
(Water well Contractors)
Topeka, Kansas 66620

1. Location of well:	County	Fraction	Section number	Township number	Range number
	Sedgwick	SW 1/4 NE 1/4 SE 1/4	23	T 28 S	R 3 E/W

2. Distance and direction from nearest town or city: #15 S. Lakeview
Street address of well location if in city: Goddard, Ks.

3. Owner of well: Mr. J. C. Tipton
R.R. or street: #15 South Lakeview
City, state, zip code: Goddard, Kansas 67052

4. Locate with "X" in section below: Sketch map:

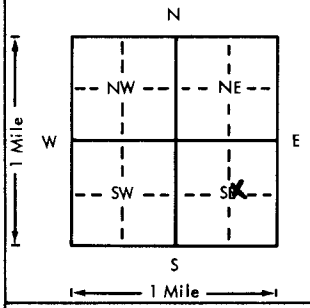

6. Bore hole dia. 11 in. Completion date 10-2-76
Well depth 125 ft.

7. __ Cable tool X Rotary __ Driven __ Dug
__ Hollow rod __ Jetted __ Bored __ Reverse rotary

8. Use: __ Domestic __ Public supply __ Industry
__ Irrigation __ Air conditioning __ Stock
X Lawn __ Oil field water __ Other

9. Casing: Material styrene Height: Above or below ////
Threaded __ Welded gl Surface 12 in.
RMP X PVC __ Weight __ lbs./ft.
Dia. 5 in. to 125 ft. depth Wall Thickness inches or
Dia. __ in. to __ ft. depth gage No. .200

5. Type and color of materiol	From	To
Topsoil	0	3
Sandy Soil	3	20
Fine Sand	20	26
Clay	26	29
Blue Shale	29	125
(Use a second sheet if needed)		

10. Screen: Manufacturer's name Sunflower Plastic
Type styrene Dia. 5"
Slot/gauge .06 Length 45'
Set between 80 ft. and 125 ft.
ft. and ft.
Gravel pack? yes Size range of material 1/4-1 1/8"

11. Static water level: mo./day/yr.
28 ft. below land surface Date 10-2-76

12. Pumping level below land surfaces:
ft. after hrs. pumping g.p.m.
ft. after hrs. pumping g.p.m.
Estimated maximum yield g.p.m.

13. Water sample submitted: mo./day/yr.
__ Yes __ No Date

14. Well head completion: capped
__ Pitless adapter 12 Inches above grade

15. Well grouted? yes
With: __ Neat cement __ Bentonite X Concrete
Depth: From 40" ft. to 14 ft.

16. Nearest source of possible contamination: Septic
ft. 55 Direction East Type Tank
Well disinfected upon completion? X Yes __ No

17. Pump: X Not installed
Manufacturer's name
Model number HP Volts
Length of drop pipe ft. capacity g.p.m.
Type:
__ Submersible __ Turbine
__ Jet __ Reciprocating
__ Centrifugal __ Other

18. Elevation:
Topography:
__ Hill
__ Slope
__ Upland
__ Valley

19. Remarks:
Flat Ground
This well to be used for yard.

20. Water well contractor's certification:
This well was drilled under my jurisdiction and this report is true to the best of my knowledge and belief.
Harp Well & Pump 236
Business name License No.
Address Wichita, Kansas
Signed M. Arnold Date
Authorized representative 11-1-76

T 28 R 3 E/W Sec 23 1/4 SW 1/4 NE 1/4 SE 1/4

Forward the white, blue and pink copies to the Department of Health and Environment

Form WWC-5

MI-1023