

|                           |                      |                |                 |              |
|---------------------------|----------------------|----------------|-----------------|--------------|
| 1 LOCATION OF WATER WELL: | Fraction             | Section Number | Township Number | Range Number |
| County: <u>Sedgwick</u>   | SW 1/4 SW 1/4 NW 1/4 | 24             | T 28 S          | R 3W E/W     |

Distance and direction from nearest town or city street address of well if located within city?

#2 Beaver Creek 1 1/2 m. S. of McArthur, E. side of Waltanna Goddard, Ks.

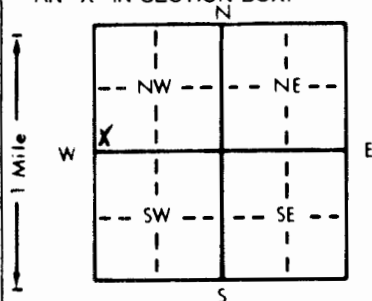
2 WATER WELL OWNER: Gibson, Greg Const.RR#, St. Address, Box #: 615 Brown Thrush

Board of Agriculture, Division of Water Resources

City, State, ZIP Code: Wichita, Kansas 67212

Application Number:

3 LOCATE WELL'S LOCATION WITH AN "X" IN SECTION BOX:

4 DEPTH OF COMPLETED WELL: 113 ft. ELEVATION:

Depth(s) Groundwater Encountered 1. . . . . ft. 2. . . . . ft. 3. . . . . ft.

WELL'S STATIC WATER LEVEL 15 ft. below land surface measured on mo/day/yr 12-19-90

Pump test data: Well water was . . . . . ft. after . . . . . hours pumping . . . . . gpm

Est. Yield . . . . . gpm: Well water was . . . . . ft. after . . . . . hours pumping . . . . . gpm

Bore Hole Diameter 11 in. to 113 ft., and . . . . . in. to . . . . . ft.

WELL WATER TO BE USED AS: 5 Public water supply 8 Air conditioning 11 Injection well

1 Domestic 3 Feedlot 6 Oil field water supply 9 Dewatering 12 Other (Specify below)

2 Irrigation 4 Industrial 7 Lawn and garden only 10 Monitoring well

Was a chemical/bacteriological sample submitted to Department? Yes . . . . . No X . . . . . If yes, mo/day/yr sample was submittedWater Well Disinfected? Yes X No

5 TYPE OF BLANK CASING USED:

5 Wrought iron

8 Concrete tile

CASING JOINTS: Glued X . . . . . Clamped . . . . .

1 Steel

3 RMP (SR)

6 Asbestos-Cement

9 Other (specify below)

Welded . . . . .

2 PVC

4 ABS

7 Fiberglass

SDR-26

Threaded . . . . .

Blank casing diameter 5 in. to 25 ft. Dia. . . . . in. to . . . . . ft. Dia. . . . . in. to . . . . . ft.Casing height above land surface 5 12 25 in., weight 2.29 lbs./ft. Wall thickness or gauge No. .214

TYPE OF SCREEN OR PERFORATION MATERIAL:

1 Steel

3 Stainless steel

5 Fiberglass

7 PVC

10 Asbestos-cement

2 Brass

4 Galvanized steel

6 Concrete tile

8 RMP (SR)

11 Other (specify)

12 None used (open hole)

SCREEN OR PERFORATION OPENINGS ARE:

1 Continuous slot

3 Mill slot

5 Gauzed wrapped

8 Saw cut

11 None (open hole)

2 Louvered shutter

4 Key punched

6 Wire wrapped

9 Drilled holes

7 Torch cut

10 Other (specify)

SCREEN-PERFORATED INTERVALS: From 25 ft. to 113 ft. From . . . . . ft. to . . . . . ft.

From . . . . . ft. to . . . . . ft. From . . . . . ft. to . . . . . ft.

GRAVEL PACK INTERVALS: From 24 ft. to 113 ft. From . . . . . ft. to . . . . . ft.

From . . . . . ft. to . . . . . ft. From . . . . . ft. to . . . . . ft.

6 GROUT MATERIAL:

1 Neat cement

2 Cement grout

3 Bentonite

4 Other . . . . .

Grout Intervals: From 4 ft. to 24 ft. From . . . . . ft. to . . . . . ft. From . . . . . ft. to . . . . . ft.

What is the nearest source of possible contamination:

1 Septic tank

4 Lateral lines

7 Pit privy

10 Livestock pens

14 Abandoned water well

2 Sewer lines

5 Cess pool

8 Sewage lagoon

11 Fuel storage

15 Oil well/Gas well

3 Watertight sewer lines

6 Seepage pit

9 Feedyard

12 Fertilizer storage

16 Other (specify below)

13 Insecticide storage

Direction from well?

South

How many feet?

120

| FROM | TO  | LITHOLOGIC LOG | FROM | TO | PLUGGING INTERVALS |
|------|-----|----------------|------|----|--------------------|
| 0    | 3   | topsoil        |      |    |                    |
| 3    | 11  | clay           |      |    |                    |
| 11   | 20  | fine sand      |      |    |                    |
| 20   | 25  | medium sand    |      |    |                    |
| 25   | 113 | grey shale     |      |    |                    |

7 CONTRACTOR'S OR LANDOWNER'S CERTIFICATION: This water well was (1) constructed, (2) reconstructed, or (3) plugged under my jurisdiction and was

completed on (mo/day/year) 12-19-90 and this record is true to the best of my knowledge and belief. KansasWater Well Contractor's License No. 236 This Water Well Record was completed on (mo/day/yr) 3-30-91under the business name of Harp Well and Pump Service, Inc. by (signature) Mary Arnold