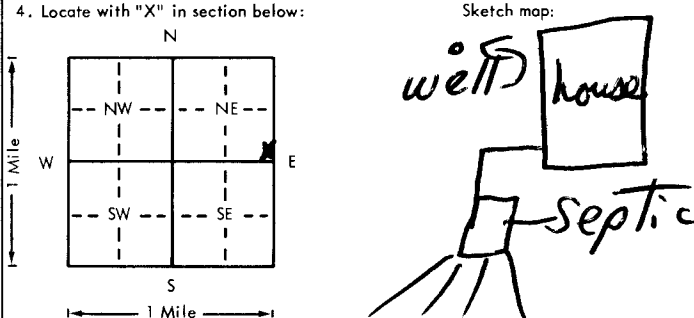


USE TYPEWRITER OR BALL
POINT PEN-PRESS FIRMLY,
PRINT CLEARLY.

WATER WELL RECORD
KSA 82a-1201-1215

Kansas Department of Health and
Environment-Division of Environment
(Water well Contractors)
Topeka, Kansas 66620

1. Location of well: County <u>Sedgwick</u> Fraction <u>SE 1/4 SE 1/4 NE 1/4</u> Section number <u>25</u> Township number <u>T 28 S</u> Range number <u>R 3 E</u>	
3. Owner of well: <u>Jim Beyle</u> R.R. or street: <u>Viola</u> City, state, zip code: <u>KS 67149</u>	
4. Locate with "X" in section below: 	
5. Type and color of material	
From To	
Top soil. 0 3	
Red clay. 3 9	
fine to med sand. 9 41	
charcoal shale. 41 44	
6. Bore hole dia. <u>4 1/4</u> in. Completion date <u>7/20/78</u> Well depth <u>44</u> ft.	
7. ☒ Cable tool ☒ Rotary ☐ Driven ☐ Dug ☐ Hollow rod ☐ Jetted ☐ Bored ☐ Reverse rotary	
8. Use: ☒ Domestic ☐ Public supply ☐ Industry ☐ Irrigation ☐ Air conditioning ☐ Stock ☐ Lawn ☐ Oil field water ☐ Other	
9. Casing: Material <u>Steel</u> Height <u>12</u> in. Above or below Threaded ☐ Welded ☒ Surface <u>12</u> in. RMP ☒ PVC Weight <u>1.50</u> lbs./ft. Dia. <u>5</u> in. to <u>4 1/4</u> ft. depth Wall thickness: inches or Dia. <u>5</u> in. to <u>4 1/4</u> ft. depth gage No. <u>200</u>	
10. Screen: Manufacturer's name <u>Sunflower</u> Type <u>200</u> Dia. <u>5 1/4</u> Slot/gauze <u>1/16</u> Length <u>6</u> ft. Set between <u>38</u> ft. and <u>40</u> ft. Gravel pack? <u>yes</u> size range of material <u>3/8</u>	
11. Static water level: <u>19</u> ft. below land surface Date <u>7/20/78</u> mo./day/yr.	
12. Pumping level below land surfaces: <u>39</u> ft. after <u>1/2</u> hrs. pumping <u>6</u> g.p.m. <u>39</u> ft. after <u>1</u> hrs. pumping <u>6</u> g.p.m. Estimated maximum yield <u>8-10</u> g.p.m.	
13. Water sample submitted: <u>no</u> mo./day/yr. ☐ Yes ☒ No Date	
14. Well head completion: <u>12</u> inches above grade ☐ Pitless adapter	
15. Well grouted? <u>yes</u> With: ☐ Neat cement ☐ Bentonite ☒ Concrete Depth: From <u>3</u> ft. to <u>13</u> ft.	
16. Nearest source of possible contamination: <u>75</u> ft. Direction <u>So</u> Type <u>Septic</u> Well disinfected upon completion? ☒ Yes ☐ No	
17. Pump: ☒ Not installed Manufacturer's name _____ Model number _____ HP _____ Volts _____ Length of drop pipe _____ ft. capacity _____ g.p.m. Type: ☐ Submersible ☐ Turbine ☐ Jet ☐ Reciprocating ☐ Centrifugal ☐ Other	
18. Elevation: _____	
19. Remarks: <u>Customer furnished 4'x4'x4" slab around casing at grade</u> <u>Per State Regulations</u> <u>Signed James R. Beyle</u>	
20. Water well contractor's certification: This well was drilled under my jurisdiction and this report is true to the best of my knowledge and belief. <u>Weninger Dully</u> 318 Business name <u>Colwich 10</u> License No. _____ Address _____ Signed <u>James R. Beyle</u> Date <u>7/20/78</u> Authorized representative	

Forward the white, blue and pink copies to the Department of Health and Environment

Form WWC-5