USE TYPEWRITER OR BALL POINT PEN-PRESS FIRMLY, PRINT CLEARLY.

WATER WELL RECORD
KSA 82a-1201-1215

Kansas Department of Health and Environment-Division of Environment
(Water well Contractors)
Topeka, Kansas 66620

1. Location of well:	County	Fraction	Section number	Township number	Range number
	Sedgwick	1/4 NE 1/4 NW 1/4	28	T 28 S	R 3W E/W

2. Distonce and direction from nearest town or city: 27217 W. 55th St. So.
Street address of well location if in city: Garden Plain, Kansas

3. Owner of well: Hahn & Hilger
R.R. or street: RR # 1
City, state, zip code: Garden Plain, Kansas

4. Locate with "X" in section below:

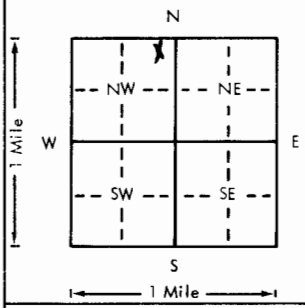

Sketch map:

6. Bore hole dia. 11 in. Completion date
Well depth 60 ft. 3-27-78

7. __ Cable tool X Rotary __ Driven __ Dug
__ Hollow rod __ Jetted __ Bored __ Reverse rotary

8. Use: X Domestic __ Public supply __ Industry
__ Irrigation __ Air conditioning __ Stock
__ Lown __ Oil field water __ Other

9. Casing: Material Styrene Weight: Above or ~~Below~~
Threaded __ Welded GL Surface 12 in.
RMP X PVC __ Weight __ lbs./ft.
Dia. 5 in. to 60 ft. depth Wall Thickness: inches or
Dia. __ in. to __ ft. depth gage No. .200

5. Type and color of material	From	To
Topsoil	0	3
Clay	3	6
Red Shale	6	45
Grey Shale	45	60

(Use a second sheet if needed)

10. Screen: Manufacturer's name Sunflower Plastic
Type styrene Dia. 5"
Slot/gauze .06 Length 45'
Set between 15 ft. and 60 ft.
ft. and ft.
Gravel pack? ~~yes~~ Size range of material 1/4-1/8"

11. Static water level: mo./day/yr.
15 ft. below land surface Date 3-27-78

12. Pumping level below land surfaces:
ft. after hrs. pumping g.p.m.
ft. after hrs. pumping g.p.m.
Estimated maximum yield g.p.m.

13. Water sample submitted: mo./day/yr.
__ Yes __ No Date

14. Well head completion: capped
__ Pitless adapter 12 Inches above grade

15. Well grouted? ~~yes~~ 1-2 Fine Sand Mix
With: __ Neat cement __ Bentonite X Concrete
Depth: From 6 ft. to 16 ft.

16. Nearest source of possible contamination: None
ft. Direction Type
Well disinfected upon completion? X Yes __ No

17. Pump: X Not installed
Manufacturer's name
Model number HP Volts
Length of drop pipe ft. capacity g.p.m.
Type:
__ Submersible __ Turbine
__ Jet __ Reciprocating
__ Centrifugal __ Other

18. Elevation:

Tapography:
__ Hill
__ Slope
__ Uplond
__ Valley

19. Remarks:
Flat Ground
Septic System not installed at this time.
No Apparent source for contamination.
Well will be in basement.

20. Water well contractor's certification:
This well was drilled under my jurisdiction and this report is true to the best of my knowledge and belief.
Harp Well & Pump 236
Business name License No.
Address Wichita, Kansas
Signed M. Arnold Date 4-28-78
Authorized representative

T 28 S R 3W E Sec 28 1/4 1/4 1/4 NE NW

Forward the white, blue and pink copies to the Department of Health and Environment

Form WWC-5

MI-1023