

WATER WELL RECORD Form WWC-5 KSA 82a-1212


1 LOCATION OF WATER WELL:	Fraction County: Gray NE $\frac{1}{4}$ NW $\frac{1}{4}$ NW $\frac{1}{4}$	Section Number 23	Township Number T 28 S	Range Number R 30 XXW
---------------------------	--	----------------------	---------------------------	-------------------------------------

Distance and direction from nearest town or city street address of well if located within city? From Montezuma - 5 Miles West on Hwy. 56

$\frac{1}{2}$ Mile North, 1 Mile West to the Southeast Corner of Section - 5,230 Ft. North, 4,414 Ft. West

2 WATER WELL OWNER:	Fry Farms, L.L.C. 1614 Bluff St.	Board of Agriculture, Division of Water Resources City, State, ZIP Code: Garden City, Kansas 67846
---------------------	-------------------------------------	---

3 LOCATE WELL'S LOCATION WITH AN "X" IN SECTION BOX:	4 DEPTH OF COMPLETED WELL. 405 ft. ELEVATION:
--	---

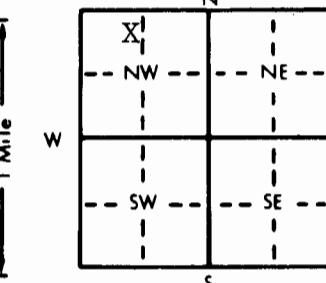

Depth(s) Groundwater Encountered 1 ft. 2 ft. 3 ft. ft.

WELL'S STATIC WATER LEVEL 170 ft. below land surface measured on mo/day/yr 7-17-95

Pump test data: Well water was ft. after hours pumping gpm

Est. Yield gpm: Well water was ft. after hours pumping gpm

Bore Hole Diameter 30 in. to 405 ft., and in. to ft.

WELL WATER TO BE USED AS: 5 Public water supply 8 Air conditioning 11 Injection well

1 Domestic 3 Feedlot 6 Oil field water supply 9 Dewatering 12 Other (Specify below)

2 Irrigation 4 Industrial 7 Lawn and garden only 10 Monitoring well

Was a chemical/bacteriological sample submitted to Department? Yes No X If yes, mo/day/yr sample was submitted

Water Well Disinfected? Yes No X

5 TYPE OF BLANK CASING USED:	5 Wrought iron 8 Concrete tile	CASING JOINTS: Glued Clamped
------------------------------	--------------------------------	--

1 Steel 3 RMP (SR) 6 Asbestos-Cement 9 Other (specify below) Welded
2 PVC 4 ABS 7 Fiberglass from 280 ft. Threaded

Blank casing diameter 16 in. to 205 ft., Dia 16 in. to 300 ft., Dia in. to ft.

Casing height above land surface 12 in., weight 42.05 lbs./ft. Wall thickness or gauge No. 250

TYPE OF SCREEN OR PERFORATION MATERIAL:

1 Steel 3 Stainless steel 5 Fiberglass 8 RMP (SR) 10 Asbestos-cement
2 Brass 4 Galvanized steel 6 Concrete tile 9 ABS 11 Other (specify)
12 None used (open hole)

SCREEN OR PERFORATION OPENINGS ARE:

1 Continuous slot 3 Mill slot 5 Gauzed wrapped 8 Saw cut 11 None (open hole)
2 Louvered shutter 4 Key punched 6 Wire wrapped 9 Drilled holes
7 Torch cut 10 Other (specify)

SCREEN-PERFORATED INTERVALS: From 205 ft. to 280 ft., From ft. to ft.

From 300 ft. to 405 ft., From ft. to ft.

GRAVEL PACK INTERVALS: From 20 ft. to 405 ft., From ft. to ft.

From ft. to ft., From ft. to ft.

6 GROUT MATERIAL: 1 Neat cement 2 Cement grout 3 Bentonite 4 Other

Grout Intervals: From 0 ft. to 20 ft., From ft. to ft., From ft. to ft.

What is the nearest source of possible contamination:

1 Septic tank	4 Lateral lines	7 Pit privy	10 Livestock pens	14 Abandoned water well
2 Sewer lines	5 Cess pool	8 Sewage lagoon	11 Fuel storage	15 Oil well/Gas well
3 Watertight sewer lines	6 Seepage pit	9 Feedyard	12 Fertilizer storage	16 Other (specify below)

Direction from well? South How many feet? 600

FROM	TO	LITHOLOGIC LOG	FROM	TO	PLUGGING INTERVALS
------	----	----------------	------	----	--------------------

See attached log

7 CONTRACTOR'S OR LANDOWNER'S CERTIFICATION: This water well was (1) constructed, (2) reconstructed, or (3) plugged under my jurisdiction and was completed on (mo/day/year) July 22, 1995 and this record is true to the best of my knowledge and belief. Kansas

Water Well Contractor's License No. 208 This Water Well Record was completed on (mo/day/yr) 7-31-95

under the business name of Minter-Wilson Drilling Co., Inc. by (signature) *Nora Keller*