


1 LOCATION OF WATER WELL: Fraction Section Number Township Number Range Number
 COUNTY: 035 GRAY SE 1/4 NW 1/4 NW 1/4 04 T 28 S R 30 W

Distance and direction from nearest town or city street address of well if located within city?
 FROM COPELAND; APPX 5 3/4 MILES NORTH & 1/2 MILE EAST

2 WATER WELL OWNER: PRAIRIE GRAIN FARMS Board of Agriculture, Division of Water Resources
 RR#, St. Address, Box #: PO BOX 2080 Application Number: 12,622
 City, State, ZIP code: GREAT BEND, KS 67530-2080

3 LOCATE WELL'S LOCATION WITH AN "X" IN SECTION BOX:

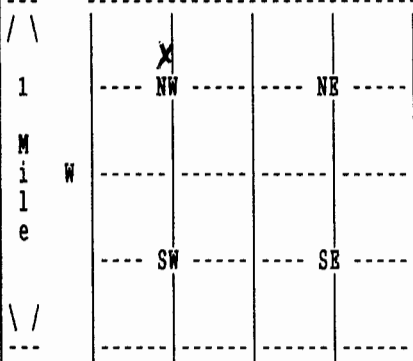

4 DEPTH OF COMPLETED WELL 514 ELEVATION: 0
 Depth(s) Groundwater Encountered 1. 0 ft. 2. 0 ft. 3. 0 ft.
 WELL'S STATIC WATER LEVEL 244 ft. below land surface measured on mo/day/yr 05/19/06
 Pump test data: Well water was 275 ft. after 4 hours pumping 1500 gpm
 Estimated Yield 0 gpm: Well water was 0 ft. after 0 hours pumping 0 gpm
 Bore Hole Diameter 24 in. to 514 ft., and in. to 0 ft.
 WELL WATER TO BE USED AS: 02 IRRIGATION
 Was a chemical/bacteriological sample submitted to department? No;
 If yes, mo/day/yr sample was submitted Water well disinfected? Yes

5 TYPE OF BLANK CASING USED: 01 STEEL CASING JOINTS: WELDED
 Blank casing diameter 16 in. to 514 ft., Dia in. to 0 ft., Dia in. to 0 ft.
 Casing height above land surface 12 in., weight 42 lbs/ft. Wall thickness or gauge No. .250
 TYPE OF SCREEN OR PERFORATION MATERIAL: 01 STEEL
 SCREEN OR PERFORATION OPENINGS ARE: 01 CONT. SLOT

SCREEN PERFORATED INTERVALS: From 320 ft. to 420 ft., From 489 ft. to 509 ft.
 From 430 ft. to 470 ft., From 0 ft. to 0 ft.
 GRAVEL PACK INTERVALS: From 20 ft. to 514 ft., From 0 ft. to 0 ft.
 From 0 ft. to 0 ft., From 0 ft. to 0 ft.

6 GROUT MATERIAL 03 BENTONITE
 Grout Intervals: From 0 ft. to 20 ft., From 0 ft. to 0 ft., From 0 ft. to 0 ft.
 What is the nearest source of possible contamination: NONE OBSERVED
 Direction from well? How many feet? 0

FROM	TO	LITHOLOGIC LOG	FROM	TO	PLUGGING INTERVALS
0	2	02 SILT			
2	40	01 CLAY 05 SAND 31 CALICHE			
40	72	01 CLAY 05 SAND			
72	80	07 FINE SAND 08 MEDIUM SAND			
80	96	01 CLAY			
96	129	05 SAND 13 FINE GRAVEL 14 MED GRAVEL			
129	133	01 CLAY			
133	163	05 SAND 13 FINE GRAVEL 14 MED GRAVEL			
163	181	01 CLAY 20 LIMESTONE			
181	229	05 SAND 11 GRAVEL 01 CLAY			

7 CONTRACTOR'S OR LANDOWNER'S CERTIFICATION: This water well was Constructed under my jurisdiction and was completed on (mo/day/year) 05/17/06 and this record is true to the best of my knowledge and belief. Kansas Water Well Contractor's License No. 145 This Water Well Record was completed on (mo/day/yr) 06/23/06 under the business name of HENKLE DRILLING & SUPPLY by (signature)

1 LOCATION OF WATER WELL: COUNTY: 035 GRAY	Fraction SE 1/4 NW 1/4 NW 1/4	Section Number 04	Township Number T 28 S	Range Number R 30 W
---	----------------------------------	----------------------	---------------------------	------------------------

2 WATER WELL OWNER: PRAIRIE GRAIN FARMS
 RR#, St. Address, Box # : PO BOX 2080
 City, State, ZIP code : GREAT BEND, KS 67530-2080

Board of Agriculture, Division of Water Resources
 Application Number: 12,622

FROM	TO	LITHOLOGIC LOG
229	267	01 CLAY 20 LIMESTONE
267	287	07 FINE SAND 01 CLAY
287	304	01 CLAY 05 SAND
304	320	07 FINE SAND 01 CLAY
320	340	07 FINE SAND 01 CLAY
340	359	07 FINE SAND 08 MEDIUM SAND 01 CLAY
359	404	05 SAND 11 GRAVEL 31 CALICHE
404	420	31 CALICHE 23 SANDSTONE 11 GRAVEL
420	425	31 CALICHE
425	432	31 CALICHE 19 SHALE 20 LIMESTONE
432	445	31 CALICHE 23 SANDSTONE
445	455	31 CALICHE 23 SANDSTONE
455	460	31 CALICHE 19 SHALE
460	470	23 SANDSTONE 31 CALICHE
470	481	19 SHALE 20 LIMESTONE
481	490	31 CALICHE 20 LIMESTONE
490	509	23 SANDSTONE 31 CALICHE
509	519	19 SHALE 20 LIMESTONE
519	560	19 SHALE 20 LIMESTONE 31 CALICHE

7 CONTRACTOR'S OR LANDOWNER'S CERTIFICATION: This water well was Constructed under my jurisdiction and was completed on (mo/day/year) 05/17/06 and this record is true to the best of my knowledge and belief. Kansas Water Well Contractor's License No. 145 This Water Well Record was completed on (mo/day/yr) 06/23/06 under the business name of HENKLE DRILLING & SUPPLY by (signature) *Bruce J. Henkle*