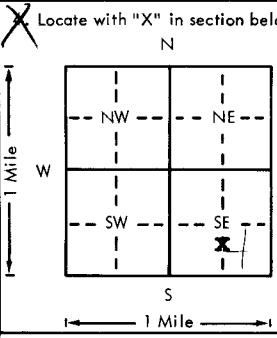


USE TYPEWRITER OR BALL  
POINT PEN-PRESS FIRMLY,  
PRINT CLEARLY.

WATER WELL RECORD  
KSA 82a-1201-1215

Kansas Department of Health and  
Environment-Division of Environment  
(Water well Contractors)  
Topeka, Kansas 66620

1. Location of well:	County <b>Gray County</b>	Section <i>NE 1/4 SE 1/4</i>	Section number <b>26</b>	Township number <b>28</b>	Range number <b>30</b>	<input checked="" type="checkbox"/> E.W.
2. Distance and direction from nearest town or city: <b>Montezuma, 1 1/2 North, 1/2 West</b>	3. Owner of well: <b>Lincoln Koehn Rt. 2 - Box 29 Copeland, KS 67837</b>					
<input checked="" type="checkbox"/> Locate with "X" in section below: 	Sketch map:					
5. Type and color of material	From	To				
<b>Casing Schedule</b>						
0 - 140 Plain						
140 - 160 Perf.						
160 - 180 Screen						
180 - 230 Perf.						
230 - 250 Screen						
250 - 260 Perf.						
(Use a second sheet if needed)						
18. Elevation:	19. Remarks:					
Topography: <input type="checkbox"/> Hill <input type="checkbox"/> Slope <input checked="" type="checkbox"/> Upland <input type="checkbox"/> Valley						
20. Water well contractor's certification: This well was drilled under my jurisdiction and this report is true to the best of my knowledge and belief. <b>Minter Wilson Drilling Co. 208</b> Business name Address Signed Authorized representative						
6. Bore hole dia. <b>26</b> in. Completion date <b>6-30-79</b> Well depth <b>260</b> ft.						
7. <input type="checkbox"/> Cable tool <input type="checkbox"/> Rotary <input type="checkbox"/> Driven <input type="checkbox"/> Dug <input type="checkbox"/> Hollow rod <input type="checkbox"/> Jetted <input type="checkbox"/> Bored <input checked="" type="checkbox"/> Reverse rotary						
8. Use: <input checked="" type="checkbox"/> Domestic <input type="checkbox"/> Public supply <input type="checkbox"/> Industry <input checked="" type="checkbox"/> Irrigation <input type="checkbox"/> Air conditioning <input type="checkbox"/> Stock <input type="checkbox"/> Lawn <input type="checkbox"/> Oil field water <input type="checkbox"/> Other						
9. Casing: Material <b>Steel</b> Height <b>1</b> above or below Threaded <input type="checkbox"/> Welded <input checked="" type="checkbox"/> Surface <b>1 ft.</b> in. RMP <input type="checkbox"/> PVC <input type="checkbox"/> Weight <b>36.87</b> lbs./ft. Dia. <b>16</b> in. to <b>260</b> ft. depth Wall Thickness: inches or Dia. <b>16</b> in. to <b>260</b> ft. depth gage No. <b>.219</b>						
10. Screen: Manufacturer's name <b>Johnson</b>						
Type <b>Johnson Galv. D 100-16"</b> Slot/gauze _____ Length _____ Set between _____ ft. and _____ ft. _____ ft. and _____ ft. Gravel pack? <b>yes</b> Size range of material <b>1/2 to 5/8</b>						
11. Static water level: <b>102</b> ft. below land surface Date <b>5-9-79</b>						
12. Pumping level below land surfaces: <b>118</b> ft. after <b>2</b> hrs. pumping <b>1050</b> g.p.m. <b>125</b> ft. after <b>4</b> hrs. pumping <b>1500</b> g.p.m. Estimated maximum yield <b>1500</b> g.p.m.						
13. Water sample submitted: Yes <input checked="" type="checkbox"/> No _____ Date _____						
14. Well head completion: <input type="checkbox"/> Pitless adapter <b>1 ft.</b> Inches above grade						
15. Well grouted? <b>yes</b> With: <input type="checkbox"/> Neat cement <input type="checkbox"/> Bentonite <input checked="" type="checkbox"/> Concrete Depth: From <b>0</b> ft. to <b>10</b> ft.						
16. Nearest source of possible contamination: ft. _____ Direction <b>N/A</b> Type _____ Well disinfected upon completion? Yes <input type="checkbox"/> No <input checked="" type="checkbox"/>						
17. Pump: Manufacturer's name <b>Gould 3 stg. 14" Bowl</b> Model number <b>200</b> HP <b>200</b> Volts Length of drop pipe <b>250</b> ft. capacity <b>1200</b> g.p.m. Type: <input type="checkbox"/> Submersible <input checked="" type="checkbox"/> Turbine <input type="checkbox"/> Jet <input type="checkbox"/> Reciprocating <input type="checkbox"/> Centrifugal <input type="checkbox"/> Other						
18. Water well contractor's certification: This well was drilled under my jurisdiction and this report is true to the best of my knowledge and belief. <b>Minter Wilson Drilling Co. 208</b> Business name Address Signed <b>John M. Wilson</b> Date <b>8/11/79</b> Authorized representative						

*For*  
Professionals **MINTER-WILSON DRILLING CO.**  
INCORPORATED

Irrigation  
and Domestic  
Water Systems  
Complete Installation  
and Repairing

Phone 276-8269 • P.O. Box A • GARDEN CITY, KANSAS 67846

April 4, 1979

Lincoln Koehn  
Gray County

Location: S. E. 1/4 26-28-30 300' South of Test #1

Static Water Level - 100

Test #3

0	2	Top Soil
2	120	Brown Clay
120	152	Fine to med. sand and gravel (loose)
152	173	Fine to med. sand and gravel small clay streak (loose)
173	185	Fine to med. sand and gravel (loose)
185	232	Brown Sandy Clay
232	250	Fine to med. sand and gravel
250	271	Brown Sandy Clay
271	310	Brown Sandy Clay
310	316	Brown Sandy Clay Brown Rock mixed
316	326	Yellow Clay Brown Rock hard
326	330	Shale

TD 260